

(605) 884-7090 www.teamtsp.com

Issued:	March 5, 2024
Bids Due:	March 19, 2024
Project Name:	City of Watertown, New City Hall Renovation and Addition
TSP Project No:	09201051

The following changes or modifications are to be incorporated into and become a part of the Contract Documents. The Bidder shall note receipt and make acknowledgement of this Addendum on the Bid Proposal, incorporating these provisions in the bid.

# **GENERAL:**

# ITEM NO 1:

In order to assist subtrades looking for active bidders, Prime Contractors are requested to advise TSP regarding intent to submit a bid. Distribution of documents is via the City of Watertown website and area plan rooms. These platforms DO NOT track plan holders, therefore, subtrades do not have access to know who to submit their bids.

A Planholder List has been included as part of this addendum containing the known planholders at this time.

# **PRODUCT APPROVALS:**

The following manufacturers and products have been approved for bidding. Final acceptance is contingent upon receipt and approval of final shop drawings/submittals. Manufacturers shall conform to all warranties, performances, sizes, materials, etc. as the item specified. The burden of proof of the merit of the proposed substitution is upon the proposer.

SECTION #	ITEM DESCRIPTION	<u>MANUFACTURER</u>
23 09 00	Building Automatic Controls Systems for HVAC	Distech - Direct Digital Control
23 37 13	Diffusers, Registers, and Grilles	Greenheck
26 51 00	Type C3	Mojo Illumination
26 51 00	Type D1, D2, D2E	Elite LED Lighting
26 51 00	Type E1, E2, E3, EM	ABB Emergilite
26 51 00	Type N4, N4E	Signify Daybrite
26 51 00	Type P1	Brownlee Lighting
26 51 00	Type U2	Rayon Lighting
26 51 00	Type W1	Spectrum Lighting, Signify Stonco
26 51 00	Type W2, W4, W6	ALW
26 51 00	Type AA	Eclipse Lighting



(605) 884-7090 www.teamtsp.com

SPECIFICAT	ON MANUAL:
ITEM NO 1:	Section 072419, Water Drainage Exterior Insulation and Finish System.
	<ul> <li>Remove Section and replace with the attached revised specification section.</li> <li>Updated system requirements and installers.</li> </ul>
ITEM NO 2:	Section 101423, Panel Signage
	Remove Section in its entirety.
ITEM NO 3:	Section 101423.23, Regulatory Panel Signage
	<ul> <li>3.D. Change the schedule elements as follows:         <ul> <li>002. Remove "MEN". Change to Female, Male graphic.</li> <li>003. Delete sign.</li> <li>Remove "ALTERNATE #2". Signs are part of Base Bid scope.</li> </ul> </li> </ul>
ITEM NO 4:	Section 122416, Pleated Window Shades
	This section has been added.
ITEM NO 5:	Section 233113, Metal Ducts
	Remove 3.9 Field Quality Control in its entirety.
	Remove 3.10 Duct Cleaning in its entirety.

DRAWINGS:	
ITEM NO 1:	<ul> <li>Drawing AD101, Demolition Floor Plan</li> <li>Remove sheet and replace with the attached revised drawing sheet.</li> <li>Included Keynote #41 in Drawing E3.</li> </ul>
ITEM NO 2:	<ul> <li>Prawing AP101, Floor Plans</li> <li>Remove sheet and replace with the attached revised drawing sheet.</li> <li>Updated reception wall length in OPEN OFFICE.</li> <li>Updated Keynote numbers.</li> <li>Updated Door 016.</li> <li>Remove Keynote on Drawing E3.</li> </ul>
ITEM NO 3:	<ul> <li>Drawing AP102, Addition Floor Plan</li> <li>Remove sheet and replace with the attached revised drawing sheet.</li> <li>Included additional detailing in MEETING.</li> </ul>
ITEM NO 4:	Drawing A-201, Exterior Elevations  Remove sheet and replace with the attached revised drawing sheet. Update Keynote #13. Updated Keynote #15. Changed Keynote #18. Included Keynote #22 in Drawing C1 and C5. Included Drawing C6. Updated Drawing B6.



(605) 884-7090 www.teamtsp.com

ITEM NO 5:	Drawing A-202, Exterior Elevations and Sections – Addition
	<ul> <li>Remove sheet and replace with the attached revised drawing sheet.</li> <li>Located Control Joint's (CJ) on drawings D2, D4, C2, and C4.</li> </ul>
ITEM NO 6:	Drawing A-602, Room Finish Schedule & Signage.
	<ul> <li>Remove sheet and replace with the attached revised drawing sheet.</li> <li>Remove signage types.</li> <li>Changed VESTIBULE flooring.</li> </ul>
ITEM NO 7:	Drawing A-701 Floor Plans and Elevations – Alternate #1
	<ul> <li>Remove sheet and replace with the attached revised drawing sheet.</li> <li>Addition of Keynote #33.</li> <li>Locating Keynote #33 on Drawings D2 and B1.</li> <li>Updating former keynote # 18 to #34.</li> </ul>
ITEM NO 8:	Drawing A-702 Sections – Alternate #1
	<ul> <li>Remove sheet and replace with the attached revised drawing sheet.</li> <li>Updating Keynote #22</li> </ul>
ITEM NO 9:	Drawing I-101, Interior Furniture Plan.
	<ul> <li>Remove sheet and replace with the attached revised drawing sheet.</li> <li>Updated arrangement in the OPEN OFFICE.</li> </ul>
ITEM NO 10:	Drawing PL101, Plumbing Plans.
	See revised drawing sheet for addition waste piping routed through lower level.
ITEM NO 11:	Drawing M-102, Mechanical Plans – Addition Mechanical Plans.
	See revised drawing sheet for revision of underground waste piping.
ITEM NO 12:	Drawing EP101, Power Plans:
	<ul> <li>See attachment for relocation of floor box outlets in Open Office 102, to be installed clear of furniture.</li> </ul>
	<ul> <li>See attachment for relocation and one removal of duplex outlets in Lobby 101. Duplex outlets shall be installed in trim between PT1 panels in wall. Coordinate with General Contractor prior to installation.</li> </ul>
	See attachment for addition of power outlet in Printing 013.
ITEM NO 13:	Drawing ET101, Power Plans:
	See attachment for reference of data floor boxes for copiers in Open Office 102.
	See attachment for addition of data outlet backbox and conduit in Printing 013.
ITEM NO 14:	Drawing E-602, Electrical Panel Schedules:
	See attachment addition of circuit for Copier in Panel B.

# **Addendum No.1**



14 W Kemp Ave Watertown, SD 57201 (605) 884-7090 www.teamtsp.com

# ATTACHMENTS:

- Planholder List
- Specification Sections: 072419, 122416
- Drawings: AD101, AP101, AP102, A-201, A-202, A-602, A-701, A-702, I-101, PL101, M-102, EP101, ET101, E-602

**END OF ADDENDUM** 

# **Planholder List**



1112 N West Ave Sioux Falls, SD 57104 (605) 336-1160 www.teamtsp.com

March 5, 2024

RE: Watertown City Hall Renovation

City of Watertown

Watertown, South Dakota TSP Project No. 09201051

Bid Date/Time: Tuesday, March 19, 2024 at 3pm local time

CONTRACTORS	
Scott Snoozy	Jordan
Comfort Plus Heating & Air Inc	Peska Construction
605-881-0796	jordan@peskaconstruction.com
Scott.snoozy7@gmail.com	605-334-0173
Dustin Brownell	Mike Keller
Gray Construction	Kyburz-Carlson Carlson Construction Co.
dustin@grayconstruct.com	mailto:mkeller@kyburzcarlson.com
	605-290-7659
Chad Huff	
Huff Construction	
Chad@huffconstructioninc.com	
605-226-0052	

PLAN ROOMS	
Aberdeen Builders Exchange Sherri (605) 290-4210 dakotabuild@midconetwork.com	Ms. Kasi Kuiper Construction Industry Center Plan Room Administrator 2771 Plant Street – P.O. Box 1227 Rapid City, SD 57702 – 57709 P: 605-343-5252 – F: 605-343-4591 kasi@constructionindustrycenter.com
Michelle Gonzales Administrative Assistant   Lincoln Builders Bureau 5910 S 58TH Street, Suite C   Lincoln, NE 68516 p: 402.421.8332   f: 402.421.8334 mgonzales@buildersbureau.com	Plains Builders Exchange 220 N Kiwanis Ave Sioux Falls SD 57104 605-334-8886 info@plainsbuilders.com
Fargo Moorhead Builders Exchange info@fmbx.org	ConstructConnect Gina.cruz@constructconnect.com 513-458-5799
Dodge Data & Analytics T (413) 507-3174   F 413-247-4968 E milica.yurong@construction.com Dodge Data & Analytics Arlington, Tx 76018	Sioux Falls Builders Exchange 1418 C Ave Sioux Falls SD 57104 Phone: (605) 357-8687 Fax: (605) 357-8655 info@sfbx.com
Master Builders of Iowa 903 6 <sup>th</sup> St Sioux City IA 51101 Phone: (712) 255-9533 Mbiplanroom-dsm@mbi.build	Lincoln Builders Bureau 5910 S. 58th St, Suite C Lincoln, NE 68516 Phone: (402) 421-8332 Fax: (402) 421-8334 info@buildersbureau.com

# **Planholder List**



1112 N West Ave Sioux Falls, SD 57104 (605) 336-1160 www.teamtsp.com

Minnesota Builders Exchange 1123 Glenwood Ave

Minneapolis MN 55405-1431 Phone: (612) 381-2620

Fax: (612) 381-2621 projects@mbex.org

Construction Industry Center 2771 Plant St Rapid City SD 57702 (605) 343-5252

cic@constructionindustrycenter.com

# SECTION 07 24 19 WATER-DRAINAGE EXTERIOR INSULATION AND FINISH SYSTEM (EIFS)

# PART 1 - GENERAL

#### 1.1 RELATED DOCUMENTS

A. Drawings and general provisions of the Contract, including General and Supplementary Conditions and Division 01 Specification Sections, apply to this Section.

# 1.2 SUMMARY

- A. Section Includes:
  - 1. EIFS-clad drainage-wall assemblies that are field applied over substrate.
  - 2. Custom Brick finish.
  - 3. Water-resistive barrier coatings.
- B. Related Requirements:
  - 1. Section 07 25 00 "Weather Barriers" for water-resistant building paper or building wrap and flexible flashings installed over sheathing behind mechanically fastened EIFS.

### 1.3 DEFINITIONS

- A. Definitions in ASTM E2110 apply to Work of this Section.
- B. EIFS: Exterior insulation and finish system(s).
- C. IBC: International Building Code.

#### 1.4 PREINSTALLATION MEETINGS

A. Preinstallation Conference: Conduct conference at Project site.

# 1.5 ACTION SUBMITTALS

- A. Product Data: For each EIFS component, trim, and accessory, including water-resistive barrier coatings.
- B. Shop Drawings:
  - Include details for EIFS buildouts.
- C. Samples: For each exposed product and for each color and texture specified, 8 inches square in size.
- D. Samples for Initial Selection: For each type of finish-coat color and texture indicated.
  - Include similar Samples of exposed accessories involving color selection.
- E. Samples for Verification: 24-inch-square panels for each type of finish-coat color and texture indicated, prepared using same tools and techniques intended for actual work, including custom trim, each profile, and an aesthetic reveal.
  - 1. Include exposed trim and accessory Samples to verify color selected.
  - 2. Include a typical control joint filled with sealant of color selected, as specified in Section 07 92 00 "Joint Sealants."

# 1.6 INFORMATIONAL SUBMITTALS

- A. Qualification Data: For Installer.
- B. Manufacturer Certificates: Signed by EIFS manufacturer, certifying the following:
  - 1. EIFS complies with requirements.
  - 2. Substrates to which EIFS is indicated to be attached are acceptable to EIFS manufacturer.
  - 3. Accessory products installed with EIFS, including joint sealants, flashing, water-resistive barrier coatings, trim, whether or not furnished by EIFS manufacturer and whether or not specified in this Section, are acceptable to EIFS manufacturer.
- C. Product Certificates: For insulation and joint sealant, from manufacturer.
- D. Product Test Reports: For each EIFS assembly and component, and for water-resistive barrier coatings.
- E. Field quality-control reports.
- F. Sample Warranty: For manufacturer's special warranty.

# SECTION 07 24 19 WATER-DRAINAGE EXTERIOR INSULATION AND FINISH SYSTEM (EIFS)

# 1.7 CLOSEOUT SUBMITTALS

A. Maintenance Data: For EIFS to include in maintenance manuals.

### 1.8 QUALITY ASSURANCE

- A. Installer Qualifications: An installer who is certified in writing by AWCI International as qualified to install Class PB EIFS using trained workers.
- B. Available installers qualified to install the "Custom Brick" system include, but are not limited to the following:
  - 1. David Kramer Drywall
  - 2. JKXteriors
  - 3. Michael Johnson Contracting
- C. Mockups: Build mockups to verify selections made under Sample submittals, to demonstrate aesthetic effects, to set quality standards for materials and execution, and to set quality standards for fabrication and installation.
  - 1. Build mockup of typical wall area(s) and details as shown on Drawings.
  - 2. Approval of mockups does not constitute approval of deviations from the Contract Documents contained in mockups unless Architect specifically approves such deviations in writing.
  - 3. Subject to compliance with requirements, approved mockups may become part of the completed Work if undisturbed at time of Substantial Completion.

# 1.9 DELIVERY, STORAGE, AND HANDLING

- A. Deliver materials in original, unopened packages with manufacturers' labels intact and clearly identifying products.
- B. Store materials inside and under cover; keep them dry and protected from weather, direct sunlight, surface contamination, aging, corrosion, damaging temperatures, construction traffic, and other causes.
  - 1. Stack insulation board flat and off the ground.
  - 2. Protect plastic insulation against ignition at all times. Do not deliver plastic insulating materials to Project site before installation time.
  - 3. Complete installation and concealment of plastic materials as rapidly as possible in each area of construction.

# 1.10 FIELD CONDITIONS

- A. Weather Limitations: Proceed with installation only when existing and forecasted weather conditions and ambient outdoor air, humidity, and substrate temperatures permit EIFS to be applied, dried, and cured according to manufacturers' written instructions and warranty requirements.
  - 1. Proceed with installation of adhesives or coatings only when ambient temperatures have remained, or are forecast to remain, above 40 deg F (4.4 deg C) for a minimum of 24 hours before, during, and after application. Do not apply EIFS adhesives or coatings during rainfall.

# 1.11 WARRANTY

- A. Manufacturer's Special Warranty: Manufacturer agrees to repair or replace components of EIFS-clad drainage-wall assemblies that fail in materials or workmanship within specified warranty period.
  - 1. Failures include, but are not limited to, the following:
    - a. Bond integrity and weathertightness.
    - b. Deterioration of EIFS finishes and other EIFS materials beyond normal weathering.
  - 2. Warranty coverage includes the following components of EIFS-clad drainage-wall assemblies:
    - a. EIFS finish, including base coats, finish coats, and reinforcing mesh.
    - b. Insulation installed as part of EIFS including foam buildouts.

# SECTION 07 24 19 WATER-DRAINAGE EXTERIOR INSULATION AND FINISH SYSTEM (EIFS)

- c. Insulation adhesive and mechanical fasteners.
- d. EIFS accessories, including trim components and flashing.
- e. Water-resistive barrier coatings.
- f. EIFS drainage components.
- 3. Warranty Period: Five **Ten** years from date of Substantial Completion.
  - a. Follow all manufacturer requirements to achieve warranty.

# B. Installer Warranty

1. System installer shall provide a separate minimum one-year warranty for all workmanship related to the proper installation and drainage performance of the EIFS application.

# PART 2 - PRODUCTS

### 2.1 MANUFACTURERS

- A. <u>Basis of Design: Dryvit Systems Inc. Outsulation Plus MD System with Custom Brick Polymer</u> Finish System for use on Vertical Walls
- B. Source Limitations: Obtain EIFS from single source from single EIFS manufacturer and from sources approved by EIFS manufacturer as compatible with EIFS components.

# 2.2 PERFORMANCE REQUIREMENTS

- A. EIFS Performance: Comply with ASTM E2568 and with the following:
  - Weathertightness: Resistant to uncontrolled water penetration from exterior, with a means to drain water entering EIFS to the exterior.
  - 2. Structural Performance of Assembly and Components:
    - a. Wind Loads: Uniform pressure as indicated on Drawings.
  - 3. Impact Performance: ASTM E2568, High impact resistance
  - 4. Abrasion Resistance of Finish Coat: Sample consisting of 1-inch-thick EIFS mounted on 1/2-inch-thick gypsum board; cured for a minimum of 28 days and shows no cracking, checking, or loss of film integrity after exposure to 528 quarts of sand when tested according to ASTM D968, Method A.
  - 5. Mildew Resistance of Finish Coat: Sample applied to 2-by-2-inch clean glass substrate; cured for 28 days and shows no growth when tested according to ASTM D3273 and evaluated according to ASTM D3274.
  - 6. Drainage Efficiency: 90 percent average minimum when tested according to ASTM E2273.

# 2.3 EIFS MATERIALS

- A. Water-Resistive Barrier Coating: EIFS manufacturer's standard formulation and accessories for use as water-resistive barrier coating; compatible with substrate.
  - Water-Resistance: Comply with physical and performance criteria of ASTM E2570/E2570M.
- B. Flexible-Membrane Flashing: Cold-applied, self-adhering, self-healing, rubberized-asphalt, and polyethylene-film composite sheet or tape and primer; EIFS manufacturer's standard or product recommended in writing by EIFS manufacturer.
- C. Insulation Adhesive: EIFS manufacturer's standard formulation designed for indicated use; specifically formulated to be applied to back side of insulation in a manner that creates open vertical channels designed to serve as an integral part of the water-drainage system of the EIFS-clad drainage-wall assembly; compatible with substrate; and complying with one of the following:
  - Factory-mixed noncementitious formulation designed for adhesive attachment of insulation to substrates of type indicated, as recommended by EIFS manufacturer.
- D. Drainage Mat: Three-dimensional, nonwoven, entangled filament, nylon or plastic [Woven or fused, self-furring, PVC mesh lath mat designed to drain incidental moisture by gravity; EIFS manufacturer's standard or product recommended in writing by EIFS manufacturer, with

# SECTION 07 24 19 WATER-DRAINAGE EXTERIOR INSULATION AND FINISH SYSTEM (EIFS)

manufacturer's standard corrosion-resistant mechanical fasteners suitable for intended substrate.

- E. Molded, (Expanded) Rigid Cellular Polystyrene Board Insulation: Comply with ASTM E2430/E2430M, unless otherwise noted, and the following:
  - 1. Flame-Spread and Smoke-Developed Indexes: 25 and 450 or less, respectively, according to ASTM E84.
  - 2. Dimensions: Provide insulation boards of not more than 24 by 48 inches, with thickness indicated on Drawings.
  - 3. Channeled Board Insulation: EIFS manufacturer's standard factory-fabricated profile with linear, vertical-drainage channels, slots, or waves on the back side of board.
  - 4. Foam Buildouts: Provide with profiles and dimensions indicated on Drawings.
- F. Reinforcing Mesh: Balanced, alkali-resistant, open-weave, glass-fiber mesh treated for compatibility with other EIFS materials, made from continuous multiend strands with retained mesh tensile strength of not less than 120 lbf/in. according to ASTM E2098/E2098M and the following:
  - 1. Reinforcing Mesh for EIFS, General: Not less than weight required to comply with impact-performance level specified in "Performance Requirements" Article.
  - 2. Strip-Reinforcing Mesh: Not less than as recommended by EIFS manufacturer.
  - 3. Detail-Reinforcing Mesh: Not less than as recommended by EIFS manufacturer.
  - 4. Corner-Reinforcing Mesh: Not less than as recommended by EIFS manufacturer.
  - 5. Provide for ultra high impact mesh assembly for all EIFS clad walls within 4'-0" of grade and where additionally indicated on the drawings.
- G. Base Coat: EIFS manufacturer's standard mixture complying with the following:
  - 1. Factory-mixed noncementitious formulation of polymer-emulsion adhesive and inert fillers that is ready to use without adding other materials.
- H. Mechanical Fasteners: EIFS manufacturer's standard corrosion-resistant fasteners, consisting of thermal cap, standard washer and shaft attachments, and fastener indicated below; designed to resist Project's design loads; capable of pulling fastener head below surface of insulation board; and complying with the following:
  - 1. For attachment to wood framing members and plywood sheathing, provide steel drill screws complying with ASTM C1002, Type W.
- I. Primer: EIFS manufacturer's standard factory-mixed, elastomeric-polymer primer for preparing base-coat surface for application of finish coat.
- J. Finish Coat: EIFS manufacturer's standard acrylic-based coating with Dirt Pickup Resistance DPR. complying with the following:
  - 1. Factory-mixed formulation of polymer-emulsion binder, colorfast mineral pigments, sound stone particles, and fillers.
  - 2. Colors: As selected by Architect from manufacturer's full range. Match Architect's sample.
    - a. At the new addition, match the fascia to the recoat and painting on the existing building.
    - b. At Alternate #1, match the adjacent, existing brick. Anticipate individual color modification to match the existing blend.
    - c. At Alternate #1, match the adjacent, existing stone.
  - 3. Textures: As selected by Architect from manufacturer's full range complete with NCB grout and Custom Brick patterns.
  - 4. Specialty Finishes and Veneers:
    - a. Custom Brick. Acrylic polymer-based finish used in conjunction with a proprietary template system to create the look of stone, brick, slate or tile.
    - b. Lymestone. Premixed, acrylic based finish designed to replicate the appearance of limestone blocks.
- K. Sealer: Manufacturer's waterproof, clear acrylic-based sealer for protecting finish coat.
- L. Water: Potable.

# SECTION 07 24 19 WATER-DRAINAGE EXTERIOR INSULATION AND FINISH SYSTEM (EIFS)

- M. Trim Accessories: Type as designated or required to suit conditions indicated and to comply with EIFS manufacturer's written instructions; manufactured from UV-stabilized PVC; and complying with ASTM D1784, manufacturer's standard cell class for use intended, and ASTM C1063.
  - Casing Bead: Prefabricated, one-piece type for attachment behind insulation, of depth required to suit thickness of coating and insulation, with face leg perforated for bonding to coating and back leg.
  - 2. Drip Screed/Track: Prefabricated, one-piece type for attachment behind insulation with face leg extended to form a drip, of depth required to suit thickness of coating and insulation, with face leg perforated for bonding to coating and back leg.
  - 3. Weep Screed/Track: Prefabricated, one-piece type for attachment behind insulation with perforated face leg extended to form a drip and weep holes in track bottom, of depth required to suit thickness of coating and insulation, with face leg perforated for bonding to coating and back leg; designed to drain incidental moisture that gets into wall construction to the exterior at terminations of EIFS with drainage.
  - 4. Expansion Joint: Closed-cell polyethylene backer rod and elastomeric sealant 3/4-inch-minimum.
  - 5. Windowsill Flashing: Prefabricated type for both flashing and sloping sill over framing beneath windows; with end and back dams; designed to direct water to exterior.
  - 6. Parapet Cap Flashing: Type for both flashing and covering parapet top, with design complying with ASTM C1397 and ANSI/SPRI/FM 4435/ES-1.

# 2.4 MIXING

A. Comply with EIFS manufacturer's requirements for combining and mixing materials. Do not introduce admixtures, water, or other materials, except as recommended by EIFS manufacturer. Mix materials in clean containers. Use materials within time period specified by EIFS manufacturer or discard.

# PART 3 - EXECUTION

### 3.1 EXAMINATION

- A. Examine substrates, areas, and conditions, with Installer present, for compliance with requirements for installation tolerances and other conditions affecting performance of the Work.
- B. Examine roof edges, wall framing, flashings, openings, substrates, and junctures at other construction for suitable conditions where EIFS will be installed.
- C. Proceed with installation only after unsatisfactory conditions have been corrected.
  - 1. Begin coating application only after surfaces are dry.
  - 2. Application of coating indicates acceptance of surfaces and conditions.

# 3.2 PREPARATION

- A. Protect contiguous work from moisture deterioration and soiling caused by application of EIFS. Provide temporary covering and other protection needed to prevent spattering of exterior finish coats on other work.
- B. Protect EIFS, substrates, and wall construction behind them from inclement weather during installation. Prevent penetration of moisture behind drainage plane of EIFS and deterioration of substrates.
- C. Prepare and clean substrates to comply with EIFS manufacturer's written instructions to obtain optimum bond between substrate and adhesive for insulation.
  - Concrete Substrates: Provide clean, dry, neutral-pH substrate for insulation installation. Verify suitability of substrate by performing bond and moisture tests recommended by EIFS manufacturer.

# SECTION 07 24 19 WATER-DRAINAGE EXTERIOR INSULATION AND FINISH SYSTEM (EIFS)

# 3.3 EIFS INSTALLATION, GENERAL

A. Comply with ASTM C1397, ASTM E2511, and EIFS manufacturer's written instructions for installation of EIFS as applicable to each type of substrate indicated.

### 3.4 SUBSTRATE PROTECTION APPLICATION

- A. Water-Resistive Barrier Coating: Apply over sheathing to provide a water-resistive barrier.
  - 1. Tape and seal joints, exposed edges, terminations, and inside and outside corners of sheathing unless otherwise indicated by EIFS manufacturer's written instructions.
- B. Flexible-Membrane Flashing: Install over water-resistive barrier coating, applied and lapped to shed water; seal at openings, penetrations, and terminations. Prime substrates with flashing primer if required and install flashing.

### 3.5 TRIM INSTALLATION

- A. Trim: Apply trim accessories at perimeter of EIFS, at expansion joints, at windowsills, and elsewhere as indicated. Coordinate with installation of insulation.
  - 1. Weep Screed/Track: Use at bottom termination edges, at window and door heads, and at floor line expansion joints] of water-drainage EIFS unless otherwise indicated.
  - 2. Windowsill Flashing: Use at windows unless otherwise indicated.

### 3.6 DRAINAGE MAT INSTALLATION

A. Drainage Mat: Apply wrinkle free, continuously, with edges butted and mechanically secured with fasteners over water-resistive barrier coating.

# 3.7 INSULATION INSTALLATION

- A. Board Insulation: Mechanically attach insulation to substrate in compliance with ASTM C1397 and the following:
  - Mechanically attach insulation to substrate. Install top surface of fastener heads flush with plane of insulation. Install fasteners into or through substrates with the following minimum penetration:
    - a. Wood Framing: 1 inch.
  - 2. Apply insulation over substrates in courses with long edges of boards oriented horizontally.
  - 3. Begin first course of insulation from a level base line and work upward.
  - 4. Begin first course of insulation from screed/track and work upward. Work from perimeter casing beads toward interior of panels if possible.
  - 5. Stagger vertical joints of insulation boards in successive courses to produce running bond pattern. Locate joints, so no piece of insulation is less than 12 inches wide or 6 inches high. Offset joints not less than 6 inches from corners of window and door openings.
    - a. Mechanical Attachment: Offset joints of insulation from horizontal joints in sheathing.
  - 6. Apply channeled insulation, with drainage channels aligned vertically.
  - 7. Interlock ends at internal and external corners.
  - 8. Abut insulation tightly at joints within and between each course to produce flush, continuously even surfaces without gaps or raised edges between boards. If gaps greater than 1/16 inch occur, fill with insulation cut to fit gaps exactly; insert insulation without using adhesive or other material.
  - 9. Cut insulation to fit openings, corners, and projections precisely and to produce edges and shapes complying with details indicated.
  - 10. Rasp or sand flush entire surface of insulation to remove irregularities projecting more than 1/32 inch from surface of insulation and to remove yellowed areas due to sun exposure; do not create depressions deeper than 1/16 inch. Prevent airborne dispersal and immediately collect insulation raspings or sandings.

# SECTION 07 24 19 WATER-DRAINAGE EXTERIOR INSULATION AND FINISH SYSTEM (EIFS)

- 11. Cut aesthetic reveals in outside face of insulation with high-speed router and bit configured to produce grooves, rabbets, and other features that comply with profiles and locations indicated. Do not reduce insulation thickness at aesthetic reveals to less than 3/4 inch.
- 12. Install foam buildouts and attach to structural substrate by adhesive and mechanical fastening.
- 13. Interrupt insulation for expansion joints where indicated.
- 14. Form joints for sealant application by leaving gaps between adjoining insulation edges and between insulation edges and dissimilar adjoining surfaces. Make gaps wide enough to produce joint widths indicated after encapsulating joint substrates with base coat and reinforcing mesh.
- 15. Form joints for sealant application with back-to-back casing beads for joints within EIFS and with perimeter casing beads at dissimilar adjoining surfaces. Make gaps between casing beads and between perimeter casing beads and adjoining surfaces of width indicated.
- 16. Before installing insulation and before applying field-applied reinforcing mesh, fully wrap board edges. Cover edges of board and extend encapsulating mesh not less than 2-1/2 inches over front and back face unless otherwise indicated on Drawings.
- 17. Treat exposed edges of insulation as follows:
  - a. Except for edges forming substrates of sealant joints, encapsulate with base coat, reinforcing mesh, and finish coat.
  - b. Encapsulate edges forming substrates of sealant joints within EIFS or between EIFS and other work with base coat and reinforcing mesh.
  - c. At edges trimmed by accessories, extend base coat, reinforcing mesh, and finish coat over face leg of accessories.
- 18. Coordinate installation of flashing and insulation to produce wall assembly that does not allow water to penetrate behind flashing and water-resistive barrier coating.
- B. Expansion Joints: Install at locations indicated, where required by EIFS manufacturer, and as follows:
  - 1. At expansion joints in substrates behind EIFS.
  - 2. Where EIFS adjoin dissimilar substrates, materials, and construction, including other FIFS
  - 3. At floor lines in multilevel wood-framed construction.
  - 4. Where wall height or building shape changes.
  - 5. Where EIFS manufacturer requires joints in long continuous elevations.

# 3.8 BASE-COAT APPLICATION

- A. Base Coat: Apply full coverage to exposed insulation with not less than 1/16-inchdry-coat thickness.
- B. Reinforcing Mesh: Embed reinforcing mesh in wet base coat to produce wrinkle-free installation with mesh continuous at corners, overlapped not less than 2-1/2 inches or otherwise treated at joints to comply with ASTM C1397. Do not lap reinforcing mesh within 8 inches of corners. Completely embed mesh, applying additional base-coat material if necessary, so reinforcing-mesh color and pattern are invisible.
- C. Double-Layer Reinforcing-Mesh Application: Where indicated or required, apply second base coat and second layer of reinforcing mesh, overlapped not less than 2-1/2 inches or otherwise treated at joints to comply with ASTM C1397 in same manner as first application. Do not apply until first base coat has cured.
- D. Additional Reinforcing Mesh: Apply strip-reinforcing mesh around openings, extending 4 inches beyond perimeter. Apply additional 9-by-12-inch strip-reinforcing mesh diagonally at corners of openings (re-entrant corners). Apply 8-inch-wide, strip-reinforcing mesh at both inside and outside corners unless base layer of mesh is lapped not less than 4 inches on each side of corners.
  - 1. At aesthetic reveals, apply strip-reinforcing mesh not less than 8 inches wide.

# SECTION 07 24 19 WATER-DRAINAGE EXTERIOR INSULATION AND FINISH SYSTEM (EIFS)

- 2. Embed strip-reinforcing mesh in base coat before applying first layer of reinforcing mesh.
- E. Foam Buildouts: Fully embed reinforcing mesh in base coat.
- F. Double Base-Coat Application: Where indicated, apply second base coat in same manner and thickness as first application, except without reinforcing mesh. Do not apply until first base coat has cured.

### 3.9 FINISH-COAT APPLICATION

- A. Primer: Apply over dry base coat.
- B. Finish Coat: Apply full-thickness coverage over dry base coat, maintaining a wet edge at all times for uniform appearance, to produce a uniform finish of color and texture matching approved sample and free of cold joints, shadow lines, and texture variations.
  - 1. Embed aggregate in finish coat to produce a uniform applied-aggregate finish of color and texture matching approved sample.
  - 2. Apply as required by manufacturer for specialty finish and veneer.
    - a. Apply additional cosmetic improvements to replicate indicated sample.
- C. Sealer Coat: Apply over dry finish coat, in number of coats and thickness required by EIFS manufacturer.

# 3.10 CLEANING AND PROTECTION

A. Remove temporary covering and protection of other work. Promptly remove coating materials from window and door frames and other surfaces outside areas indicated to receive EIFS coatings.

# **END OF SECTION 07 24 19**

# SECTION 12 24 16 PLEATED WINDOW SHADES

# PART 1 - GENERAL

### 1.1 RELATED DOCUMENTS

A. Drawings and general provisions of the Contract, including General and Supplementary Conditions and Division 01 Specification Sections, apply to this Section.

# 1.2 SUMMARY

- A. Section Includes:
  - Cellular pleated shades.

# 1.3 ACTION SUBMITTALS

- A. Product Data: For each type of product.
- B. Shop Drawings: Show fabrication and installation details for pleated shades.
- Samples: For each exposed product and for each color and texture specified, 10 inches (250 mm) long.
- D. Samples for Initial Selection: For each type of pleated shade.
  - 1. Include Samples of accessories involving color selection.

### 1.4 CLOSEOUT SUBMITTALS

A. Maintenance Data: For pleated shades to include in maintenance manuals.

### 1.5 MAINTENANCE MATERIAL SUBMITTALS

- A. Furnish extra materials that match products installed and that are packaged with protective covering for storage and identified with labels describing contents.
  - 1. Pleated Shades: Full-size units equal to 5 percent of quantity installed for each size, color, texture, and pattern indicated, but no fewer than two units.

# 1.6 QUALITY ASSURANCE

A. Installer Qualifications: Fabricator of products.

# 1.7 DELIVERY, STORAGE, AND HANDLING

A. Deliver pleated shades in factory packages, marked with manufacturer, product name, and location of installation using same designations indicated on Drawings.

# 1.8 FIELD CONDITIONS

- A. Environmental Limitations: Do not install pleated shades until construction and finish work in spaces, including painting, is complete and ambient temperature and humidity conditions are maintained at the levels indicated for Project when occupied for its intended use.
- B. Field Measurements: Where pleated shades are indicated to fit to other construction, verify dimensions of other construction by field measurements before fabrication and indicate measurements on Shop Drawings. Allow clearances for operating hardware of operable glazed units through entire operating range. Notify Architect of installation conditions that vary from Drawings. Coordinate fabrication schedule with construction progress to avoid delaying the Work.

# PART 2 - PRODUCTS

# 2.1 CELLULAR PLEATED SHADES

- A. Cellular Pleated Shades: Horizontally folded shades with multiple fabric layers that form accordion folds that enclose airspaces or cells between the fabric layers.
  - Manufacturers: Subject to compliance with requirements, provide products by the following:
    - a. Hunter Douglas Contract, Duette FR Honeycomb Shades.

# SECTION 12 24 16 PLEATED WINDOW SHADES

- B. Source Limitations: Obtain cellular pleated shades from single source from single manufacturer.
- C. Cellular Pleated-Shade Construction: Two fabric thicknesses.
- D. Shade Face Fabric: Stain and fade resistant.
  - 1. Flame-Resistance Rating: Comply with NFPA 701; testing by a qualified testing agency. Identify products with appropriate markings of applicable testing agency.
  - 2. Type: Manufacturer's standard.
  - 3. Fabric Width: As required to produce shades without seams for locations indicated and as indicated on Drawings.
  - 4. Color: As selected by Architect from manufacturer's full range.
  - 5. Opacity: Semi-opaque and Opaque.
  - 6. Pleat size: 3/4".
- E. Shade Backup Fabric: Stain and fade resistant.
  - 1. Flame-Resistance Rating: Comply with NFPA 701; testing by a qualified testing agency. Identify products with appropriate markings of applicable testing agency.
  - 2. Type: Manufacturer's standard.
  - 3. Fabric Width: Matching face fabric.
  - 4. Color: As selected by Architect from manufacturer's full range.
- F. Headrail: Extruded aluminum. Headrails fully enclose operating mechanisms on three sides and have capped ends.
  - 1. Capacity: One shade per headrail unless otherwise indicated.
  - 2. Manual Operating Mechanisms: Manufacturer's standard cordless-control system with top down/ bottom up capabilities.
- G. Bottom Rail: Formed-steel or extruded-aluminum tube that secures end of shade fabric and has capped ends.
- H. Mounting Brackets: With spacers and shims required for shade placement and alignment indicated.
  - 1. Intermediate Support: Provide intermediate support brackets to produce support spacing recommended by shade manufacturer for weight and size of shade.
- I. Hold-Down Brackets: Manufacturer's standard.
- J. Valance: Manufacturer's standard with fabric insert matching shade fabric.
- K. Component Colors: Provide rails, cords, and other materials exposed to view in colors as selected by Architect from manufacturer's full range.

# PART 3 - EXECUTION

### 3.1 EXAMINATION

- A. Examine substrates, areas, and conditions, with Installer present, for compliance with requirements for installation tolerances, operational clearances, locations of connections to building electrical system, and other conditions affecting performance of the Work.
- B. Proceed with installation only after unsatisfactory conditions have been corrected.

# 3.2 ADJUSTING

A. Adjust and balance pleated shades to operate smoothly, easily, safely, and free from binding or malfunction through entire operational range.

### 3.3 CLEANING AND PROTECTION

- Clean pleated-shade surfaces after installation, according to manufacturer's written instructions.
- B. Provide final protection and maintain conditions, in a manner acceptable to manufacturer and Installer, that ensures that pleated shades are without damage or deterioration at time of Substantial Completion.
- C. Replace damaged pleated shades that cannot be repaired, in a manner approved by Architect, before time of Substantial Completion.

# **SECTION 12 24 16 PLEATED WINDOW SHADES**


#### 3.4 **DEMONSTRATION**

Engage a factory-authorized service representative to train Owner's maintenance personnel to A. adjust, operate, and maintain motorized operators for pleated shades.

**END OF SECTION 12 24 16** 

# SECTION 12 24 16 PLEATED WINDOW SHADES

THIS PAGE INTENTIONALLY LEFT BLANK

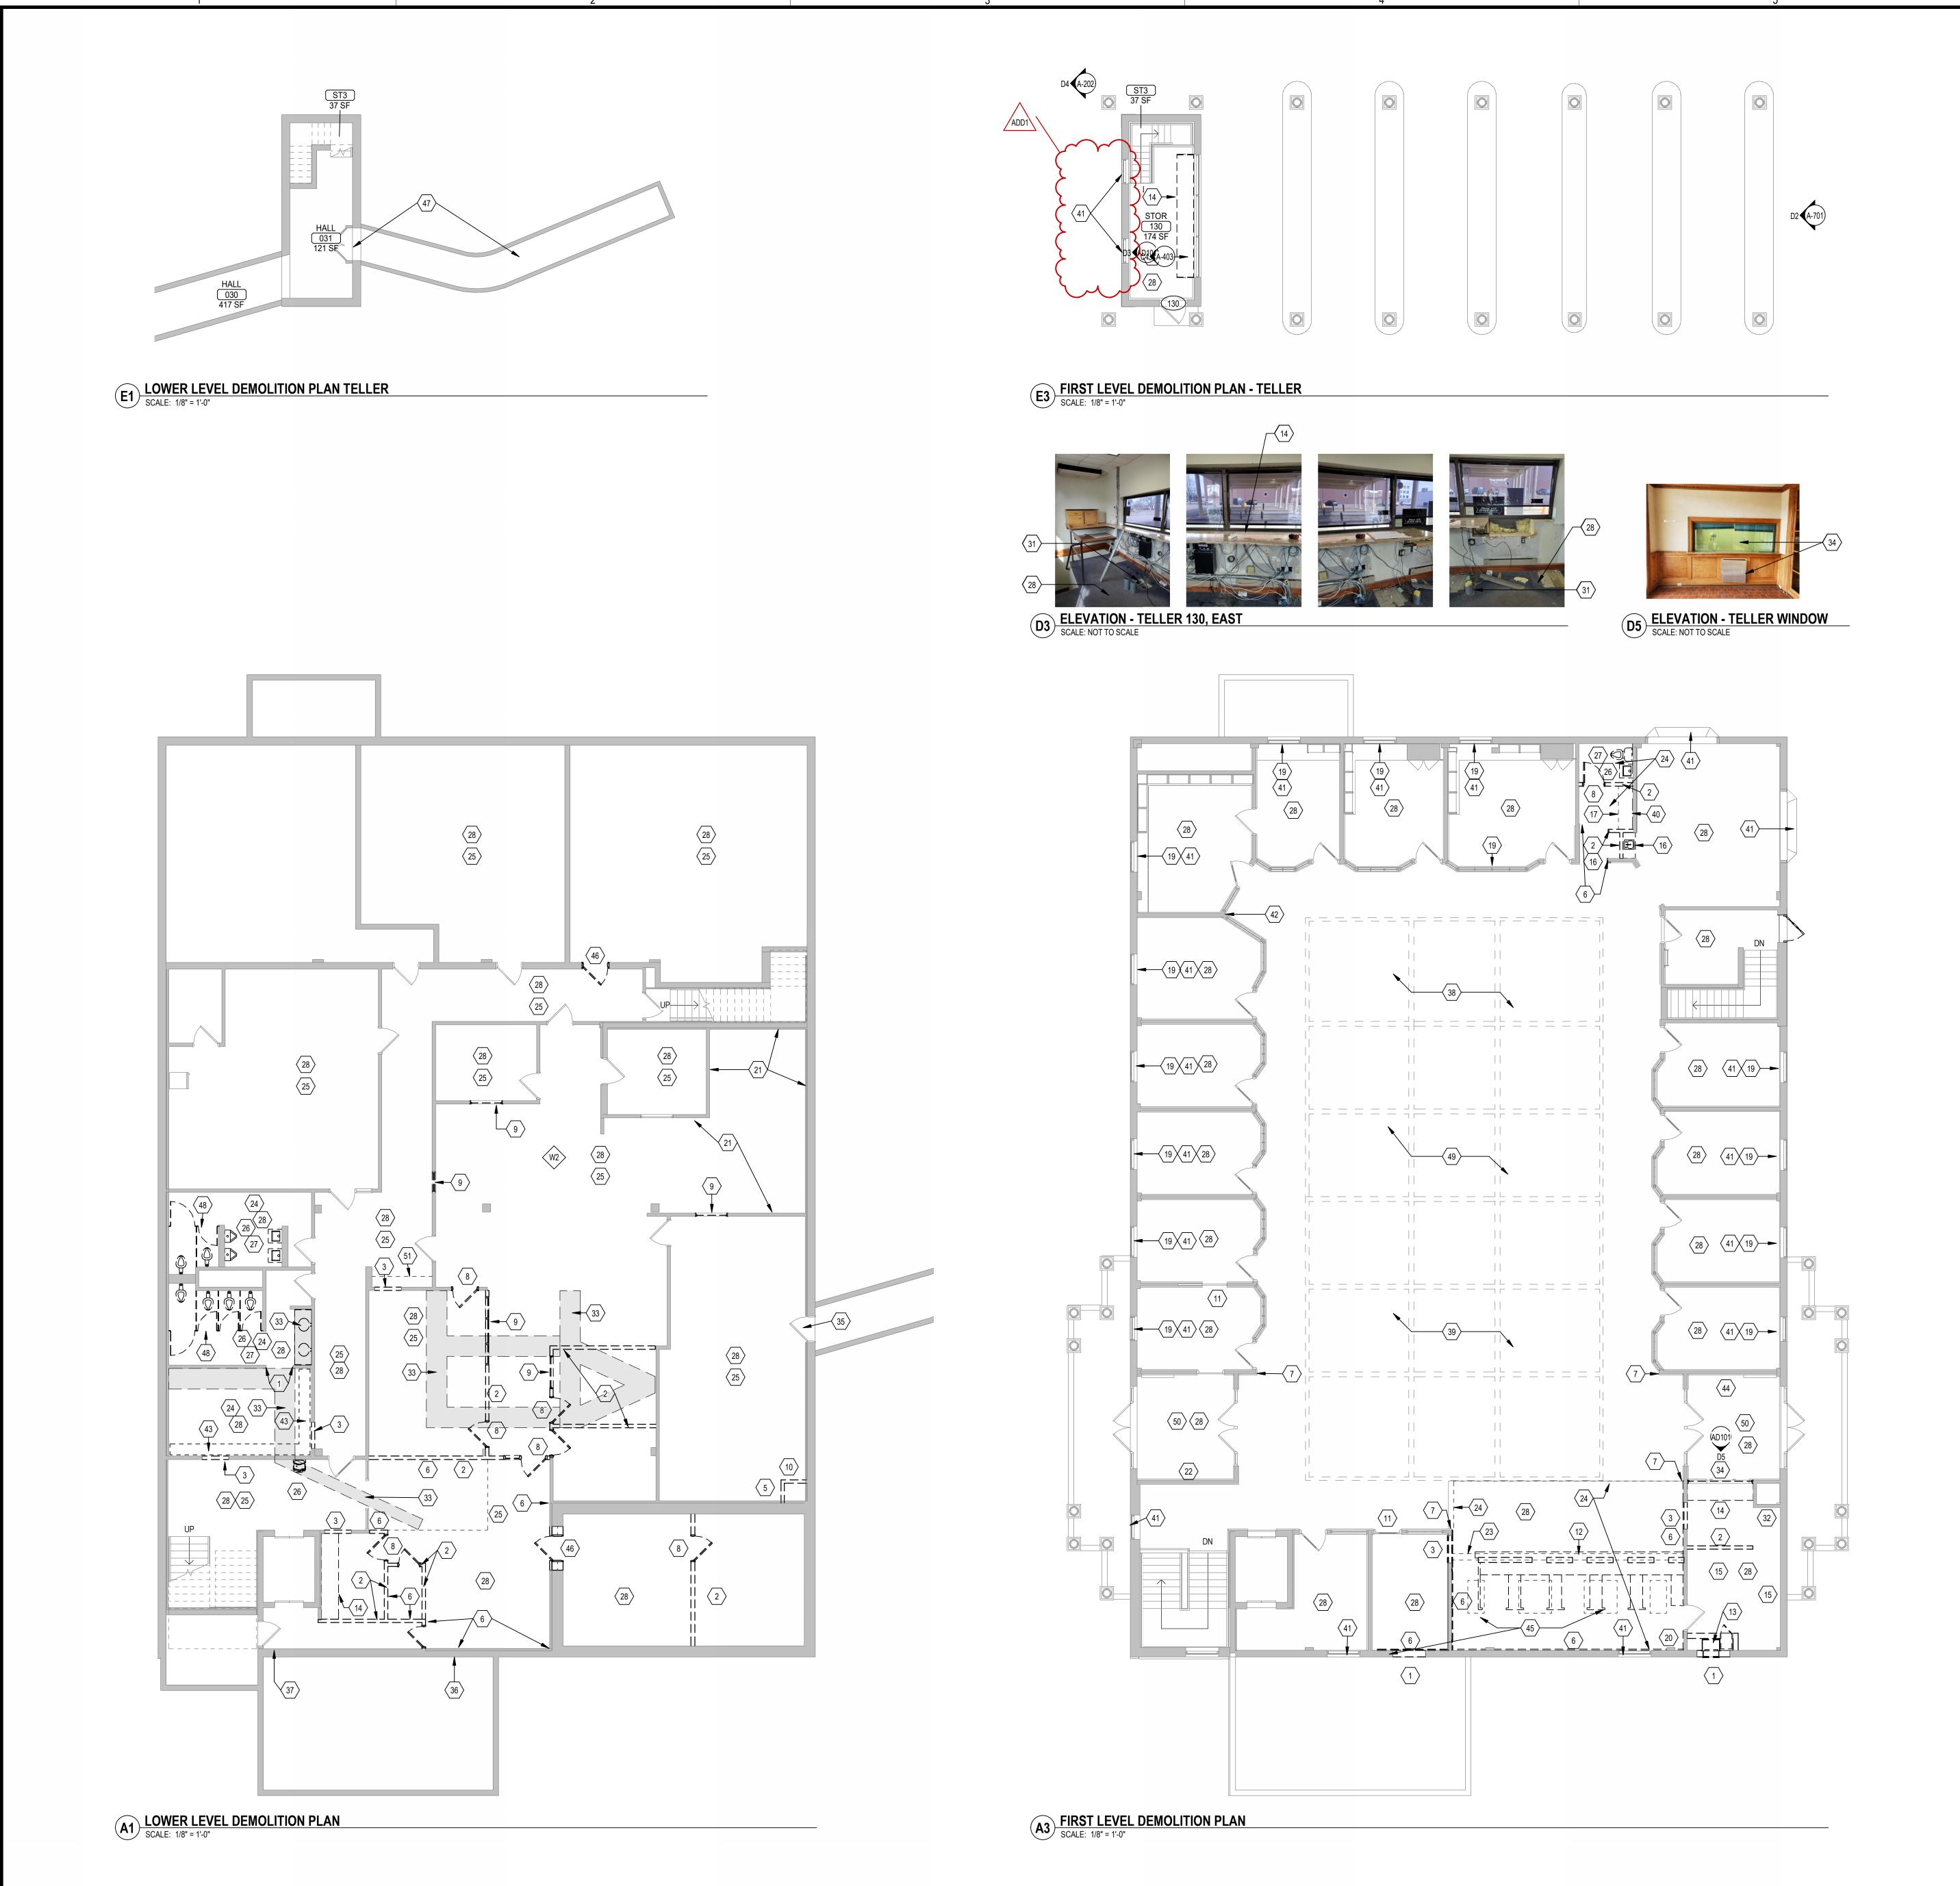

# **SHEET GENERAL NOTES:**

- GENERAL CONTRACTOR IS RESPONSIBLE FOR ALL DEMOLITION NECESSARY TO ALLOW FOR COMPLETION OF WORK AS DESCRIBED IN THE CONSTRUCTION DOCUMENTS - DEMOLITION OPERATIONS SHALL INCLUDE, BUT ARE NOT LIMITED TO THE ITEMS DESCRIBED BY KEYNOTES HEREIN. REFERENCE STRUCTURAL, MECHANICAL, AND ELECTRICAL DOCUMENTS FOR ADDITIONAL INFORMATION.
  - ALL SURFACES DAMAGED DURING DEMOLITION SHALL BE REPAIRED FOR APPLICATION OF NEW FINISHES OR PATCHED TO MATCH EXISTING. INDEPENDENT TRADES ARE RESPONSIBLE FOR THEIR RESPECTIVE CUT AND PATCH. R
- CONTRACTOR SHALL FIELD VERIFY ALL EXISTING CONDITIONS AND DIMENSIONS WHICH ARE TO MATCH EXISTING CONSTRUCTION. CONTACT A/E WITH DISCREPANCIES
- SALVAGE ALL EXISTING REMOVED WOOD COMPONENTS (TELLER, PANELS, TRIM AND MOLDINGS) FOR REUSE IN REPAIR AREAS.
- WHERE EXISTING WALL/ FLOOR FINISHES ARE REMOVED. PATCH AND REPAIR SUBSTRATES FOR PROPOSED FINISHES.

# **◯ KEY NOTES:**

- EXISTING CASED OPENING TO REMAIN. PREPARE FRAME FOR NEW DOOR. REMOVE PORTION OF EXISTING INTERIOR WALL ASSEMBLY. WOOD STUD. FULL HEIGHT. REMOVE PORTION OF EXISTING INTERIOR WALL ASSEMBLY. WOOD STUD. FOR NEW
- REMOVE PORTION OF EXISTING MASONRY WALL. FULL HEIGHT. REMOVE PORTION OF EXISTING DUMBWAITER SHAFT. FLOOR TO FLOOR.
- REMOVE PORTION OF EXISTING WOOD PANEL AND TRIM ASSEMBLY. SALVAGE FOR REUSE IN REPAIR AREAS. PATCH, FILL HOLES, PREPARE SURFACE FOR NEW FINISH. REMOVE PORTION OF EXISTING WOOD PANEL AND TRIM ASSEMBLY TO INSTALL NEW
- WALL/FRAME ASSEMBLY. REMOVE EXISTING DOOR AND FRAME ASSEMBLY.
- REMOVE EXISTING WOOD FRAMED WINDOW. 10. REMOVE EXISTING DUMBWAITER HOISTWAY ENTRANCE.
- 11. REMOVE PORTION OF EXISTING DOOR HARDWARE.
- 12. REMOVE EXISTING TELLER COUNTER ASSEMBLY. 13. REMOVE EXISTING NIGHT DEPOSITORY ASSEMBLY. ONE DEPOSITORY THROUGH THE
- EXTERIOR WALL. TWO SAFES. PATCH FLOOR FLUSH WITH ADJACENT SURFACES. 14. REMOVE EXISTING COUNTER. PATCH HOLES TO MATCH ADJACENT SURFACES.
- 15. REMOVE EXISTING SURFACE MOUNTED SHELF. 16. REMOVE EXISTING BUILT IN SHELVING.
- 17. REMOVE EXISTING COAT ROD AND SHELF. CLEAN, SALVAGE, REINSTALL 18. REMOVE EXISTING COUNTER.
- 19. REMOVE EXISTING SURFACE MOUNTED CURTAIN RAIL. 20. REMOVE EXISTING FIRE EXTINGUISHER CABINET. SALVAGE FIRE EXTINGUISHER FOR
- 21. REMOVE EXISTING ACOUSTIC TILE FROM WALL.
- 22. EXISTING DISPLAY CASE TO REMAIN. MODIFY AS DIRECTED WITHIN DOCUMENTS.. 23. REMOVE EXISTING BULKHEAD ABOVE TELLER LINE.
- 24. REMOVE PORTION OF EXISTING GYPSUM BOARD CEILING ASSEMBLY.
- 25. REMOVE PORTION OF EXISTING SUSPENDED CEILING ASSEMBLY. 26. REMOVE EXISTING PLUMBING FIXTURE.
- 27. REMOVE EXISTING TOILET ACCESSORIES. 28. REMOVE EXISTING FLOORING AND VINYL BASE WHERE OCCURS.
- NOT USED. NOT USED.
- 31. CUT OFF PENETRATIONS FLUSH WITH FLOOR. CAP/FILL PENETRATIONS FLUSH WITH ADJACENT SURFACE.
- 32. EXISTING DUMBWAITER SHAFT TO REMAIN ON THIS FLOOR. EXISTING SHAFT TO REMAIN TO PROVIDE ACCESS BETWEEN CEILING CAVITIES.
- 33. SHADED AREA REPRESENTS APPROXIMATE CUT AND PATCH AREA OF SLAB ON GRADE FOR UNDERFLOOR UTILITIES. 34. REMOVE EXISTING TELLER WINDOW AND PASS THRU ASSEMBLY.
- 35. REMOVE EXISTING BOX CONCEALING PIPE/CONDUIT TRANSITION 36. COORDINATE WITH MECHANICAL AND ELECTRICAL FOR NEW PENETRATION. PROVIDE
- WATERPROOFING AROUND NEW PENETRATION.
- 37. COORDINATE WITH MECHANICAL ON REMOVAL OF EXISTING PIPING PENETRATION. PATCH VOID TO MATCH ADJACENT SURFACE AND WATERPROOF EXTERIOR.
- 38. COORDINATE WITH ELECTRICAL TO PATCH ABANDONED FLOOR PENETRATIONS. PATCH TO MATCH ADJACENT SURFACE.
- 39. REMOVE, SALVAGE, CLEAN AND REINSTALL EXISTING LAY-IN GRILL PANELS FOR ACCESS TO LOCATION OF NEW FIRE SPRINKLER INSTALLATION.
- REMOVE EXISTING WALL BOARD FOR ACCESS TO EXISTING PLUMBING.
  REMOVE EXISTING/REMAINING WINDOW MUNTIN. CLEAN WINDOWS AND ADHESIVE
- 42. REMOVE EXISTING WALLCOVERING AND ADHESIVE. PREPARE SURFACE FOR NEW FINISH.
   43. REMOVE EXISTING LOCKERS, BASE, AND RELATED ITEMS. SALVAGE PORTION FOR
- 44. EXISTING DISPLAY CASE TO REMAIN.45. REMOVE EXISTING LIGHT FIXTURE ASSEMBLY.
- SAW CUT AND REMOVE EXISTING VAULT DOOR ASSEMBLY. EXISTING UNDERGROUND CRAWL SPACE FOR PNEUMATIC TUBES AND ACCESS CABINET TO REMAIN. APPROXIMATE LOCATION.
- REMOVE EXISTING TOILET PARTITIONS. SALVAGE (6) LOCKERS FOR REINSTALLATION. REMOVE EXISTING FLOORING THROUGHOUT ENTIRE FLOOR. SALVAGE PORTION OF
- EXISTING CARPET TILE. REINSTALL IN 130.
  REMOVE EXISTING TILE AND BASE. PREP FOR NEW FINISH.
- REMOVE EXISTING ROD AND SHELF. PATCH MOUNTING HOLES.



14 W. Kemp Ave. Watertown, SD 57201

(605) 884-7090

Architecture Engineering

www.teamtsp.com

CONSULTANTS


**CITY OF WATERTOWN RENOVATION AND ADDITION FOR NEW CITY HALL** WATERTOWN, SD

ISSUE DATE DESCRIPTION

PROJECT#

**DEMOLITION FLOOR** 

CHECKED BY

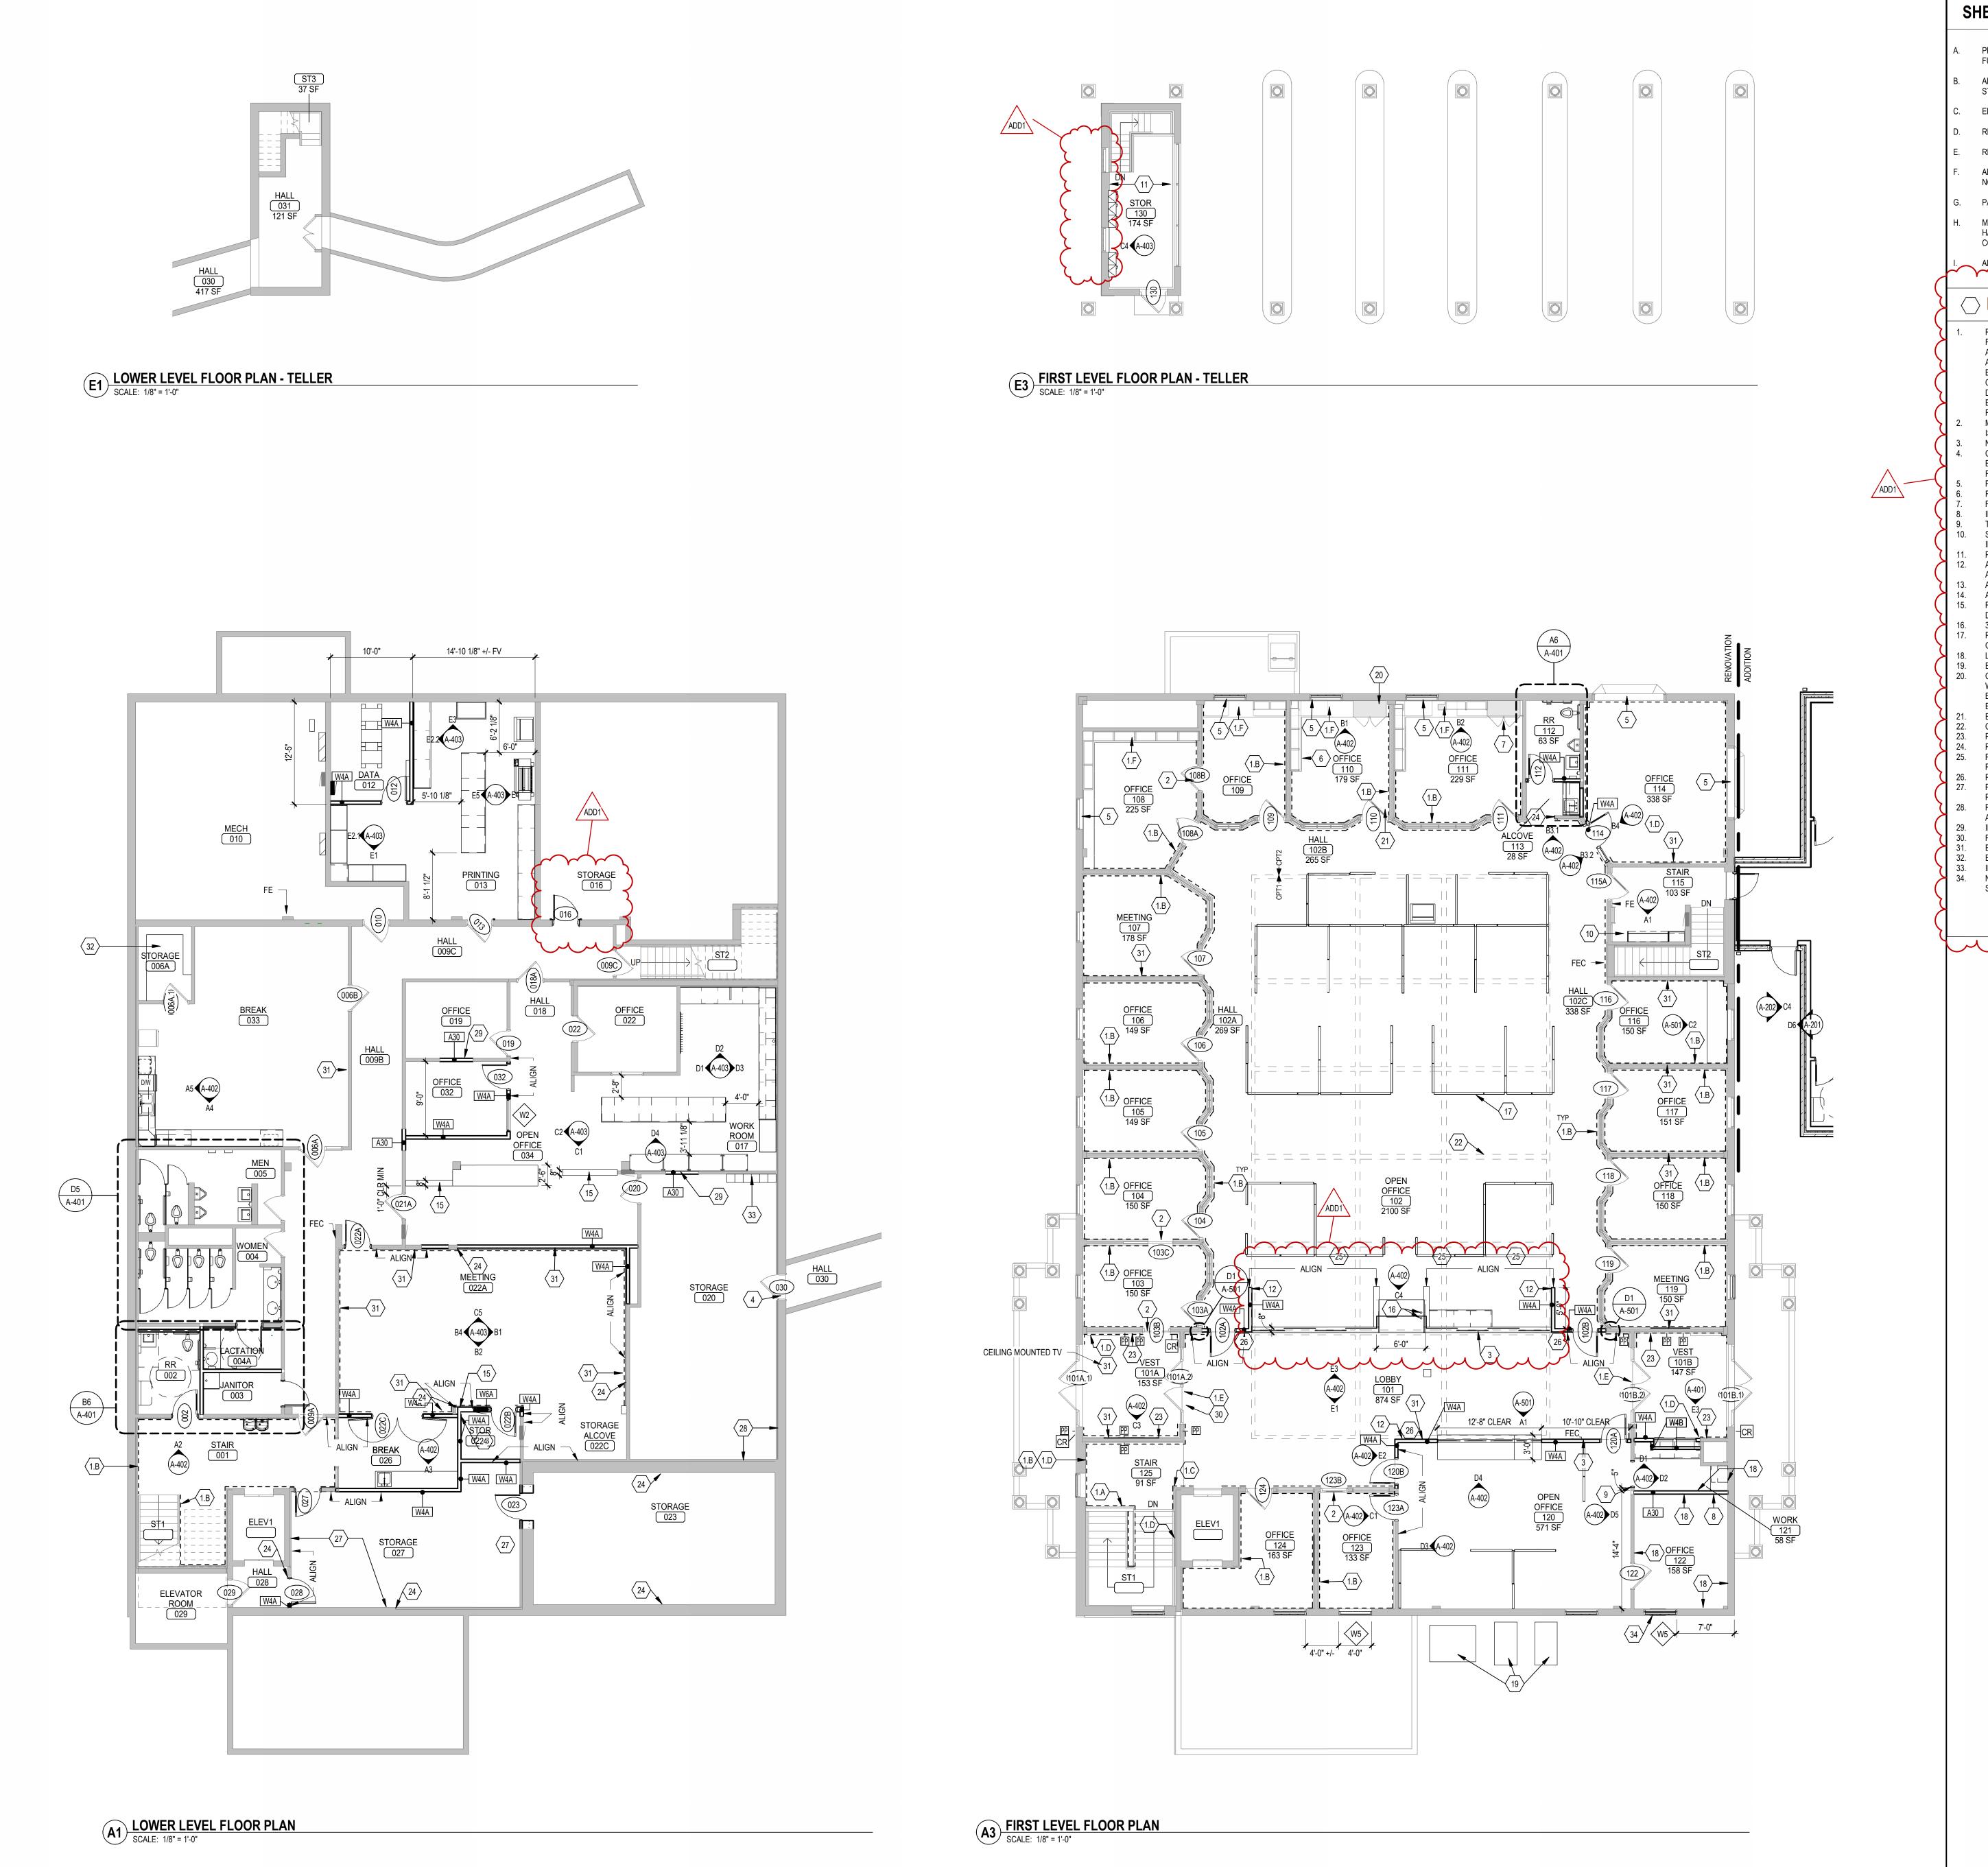



- A. PROVIDE BLOCKING AT PARTITIONS AS REQUIRED FOR MOUNTING OF FURNISHED AND NON-FURNISHED WALL MOUNTED ITEMS.
- ALIGN FINISHED FACE OF CONTINUOUS PARTITIONS THAT CHANGE PARTITION TYPES ALONG A STRAIGHT RUN.
- EDGE OF INTERIOR DOOR FRAMES TO BE 4" FROM ADJACENT WALL, UNLESS NOTED OTHERWISE.
- REFER TO SHEET A-601 FOR DOOR TYPES, WINDOW TYPES, AND NOTES.
- REFER TO SHEET A-602 FOR ROOF FINISH SCHEDULE, KEYS AND GENERAL NOTES.
- ALL WALL DIMENSIONS ARE TO FACE OF GYPSUM BOARD, CMU, BRICK, OR CONCRETE; UNLESS NOTED OTHERWISE
- PATCH HOLES IN EXPOSED GYPSUM BOARD SURFACES TO REMAIN.
- MILLWORK CONTRACTOR SHALL COORDINATE WITH ELECTRICAL CONTRACTOR AND DOOR HARDWARE FOR REMOVAL, MODIFICATION, AND REINSTALLATION OF EXISTING WOOD TRIM TO CONCEAL WIRING FOR NEW ELECTRIFIED DEVICES.

# ALL INTERIOR WALL TYPES ARE TYPE W4A UNO

# 

- 1. REFINISH EXISTING MILLWORK WITH WORN OR DAMAGED FINISHES. MATCH ADJACENT FINISHED SURFACES. REFRESH REMAINING FINISHES, CLEAN AND POLISH. REFERENCE ALLOWANCE NO. 3 FOR ADDITIONAL INFORMATION.
  - A. HANDRAIL

    B. BASEBOARD

    C. CORNER TRIM
  - PANELS AND ADJACENT TRIM
  - E. DOORS AND ADJACENT TRIM
    F. BUILT-IN CABINETRY
- MODIFY EXISTING DOOR. REFER TO DOOR SCHEDULE FOR ADDITIONAL NOTES. DOOR PANEL IS TO BE SECURED IN CLOSED POSITION.
- NEW FEC FOR EXISTING FE.

  CONSTRUCT BOX OF MATERIAL MATCHING MILLWORK IN ROOM. WRAP CROWN AROUND THE BOX. REMOVE THE EXISTING CONSTRUCTION. BOX IS TO CONCEAL TRANSITION OF UTILITY FROM CEILING CAVITY INTO ADJACENT TUNNEL APPROXIMATELY 6" OUT FROM WALL.TBD.
- REFINISH EXISTING WOOD WINDOW SILL. STAIN AND FINISH TO MATCH EXISTING.
  FABRICATE AND INSTALL CASEWORK DOOR TO MATCH EXISTING.
- 7. REPAIR CASEWORK DOOR TO ENSURE PROPER CLOSURE AND OPERATIONS.
  3. INFILL FORMER OPENING TO MATCH ADJACENT WALL AND WOOD TRIM/PANELING.
  4. TYPICAL CASED OPENING, REFERENCE A-601 FRAME TYPES.
- SALVAGED COAT ROD AND SHELF. FINISH EXPOSED ENDS TO MATCH THE REST OF THE UNIT. INSTALL IN NEW LOCATION.
   PATCH UNITSED HOLES IN GYPSLIM BOARD WALLS.
- 11. PATCH UNUSED HOLES IN GYPSUM BOARD WALLS.
   12. ALIGN NEW WALL TO BACK SIDE OF CEILING TRIM. REFERENCE B5/A-501 FOR LOCATION AND ALIGNMENT OF NEW WALL WITH EXISTING CONSTRUCTION.
- ALIGNMENT OF NEW WALL WITH EXISTING CONSTRUCTION.


  13. ALIGN DOOR FRAME WITH EXISTING BAY WINDOW PROJECTION.

  14. ALIGN NEW WALL TO EDGE OF WINDOW TRIM.
- 15. REFERENCE STRUCTURAL FOR SUPPORT REQUIRED ON NEW PARTIAL HEIGHT WALL PER DETAIL A6/S-001.
- 16. 3" GROMMET.
   17. PROPOSED MODULAR FURNITURE WORKSTATION ARRANMENT PROVIDED FOR REFERENCE
- ONLY.

  18. LAMINATE 3/8" GYPSUM BOARD OVER FACE OF EXISTING WALL. FULL HEIGHT.

  19. EXTERIOR EQUIPMENT PADS. COORDINATE SIZE, LOCATION, & QUANTITY WITH MECHANICAL.
- 20. COORDINATE WITH MECHANICAL ON LOCATION OF NEW FDC. CONSTRUCT PLYWOOD BOX WITH FINISH VENEER MATCHING CASEWORK. BOX TO BE APPROX WIDTH OF DOOR, DEPTH TO BE LESS THAN DEPTH OF CABINET WITH DOOR CLOSED. HEIGHT TO BE COORDINATED WITH EXTERIOR INSTALLATION HEIGHT.

  21. EXISTING ELECTRICAL CONDUIT TO REMAIN. PRIME AND PAINT WALL FIELD COLOR.
- 22. COFFER ARRANGEMENT IN HIGH CEILING ABOVE FOR REFERENCE ONLY.
   23. REMOVE EXISTING PANEL INFILL AND REPLACE WITH NEW TILE INFILL AS USED IN LOBBY.
   24. PATCH AND REPAIR WALL TO MATCH ADJACENT SURFACES.
- 25. PROVIDE SIGN TYPE 1, TO BE INSTALLED ON FURNITURE GLASS PANELS, FURNITURE N.I.C. REFERENCE A-602.
- 26. PROVIDE SIGN TYPE 2, REFERENCE A-602.
  27. REPAIR EXISTING FURRED WALL SUBSTRATE FROM REMOVAL OF THE WOOD WAINSCOT. PREP FOR NEW FINISH TYPOM REMOVAL OF PUMPINAL FROM REMOVAL PUMPINAL FROM REMOVAL PUMPINAL FROM REMOVAL PUMPINAL FROM REMOVAL PUMPINAL
- REPAIR EXISTING WALL FROM REMOVAL OF DUMBWAITER SHAFT. FLUSH WITH EXISTING ADJACENT SURFACES. PREP FOR NEW FINISH.
   INFILL OPENING WITH CONSTRUCTION TO MATCH EXISTING FLUSH W/ADJACENT SURFACES.
   REPLACE DAMAGED WOOD DOOR STOP TRIM.
   EXTENT OF WOOD WAINSCOT. SEE ELEVATIONS AND DETAIL D2/A-501.
- 31. EXTENT OF WOOD WAINSCOT. SE 32. EXISTING SHELVING TO REMAIN.
- 33. INSTALL SALVAGED LOCKERS.
   34. NEW OPENING IN EXISTING STUD WALL CONSTRUCTION. REFERENCE STRUCTURAL FOR SPECFIC INFORMATION.

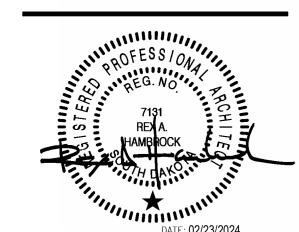

14 W. Kemp Ave. Watertown, SD 57201

(605) 884-7090

Architecture Engineering

www.teamtsp.com

CONSULTANTS

PROJECT TITLE

CITY OF WATERTOWN RENOVATION AND ADDITION FOR NEW CITY HALL WATERTOWN, SD

ADD1 03/05/2024 ADD1
ISSUE DATE DESCRIPTION

| DRAWN BY | DRAWN BY


SHEET TITLE

**FLOOR PLANS** 

NI IMPED

**AP101** 

SP. Inc. 2024

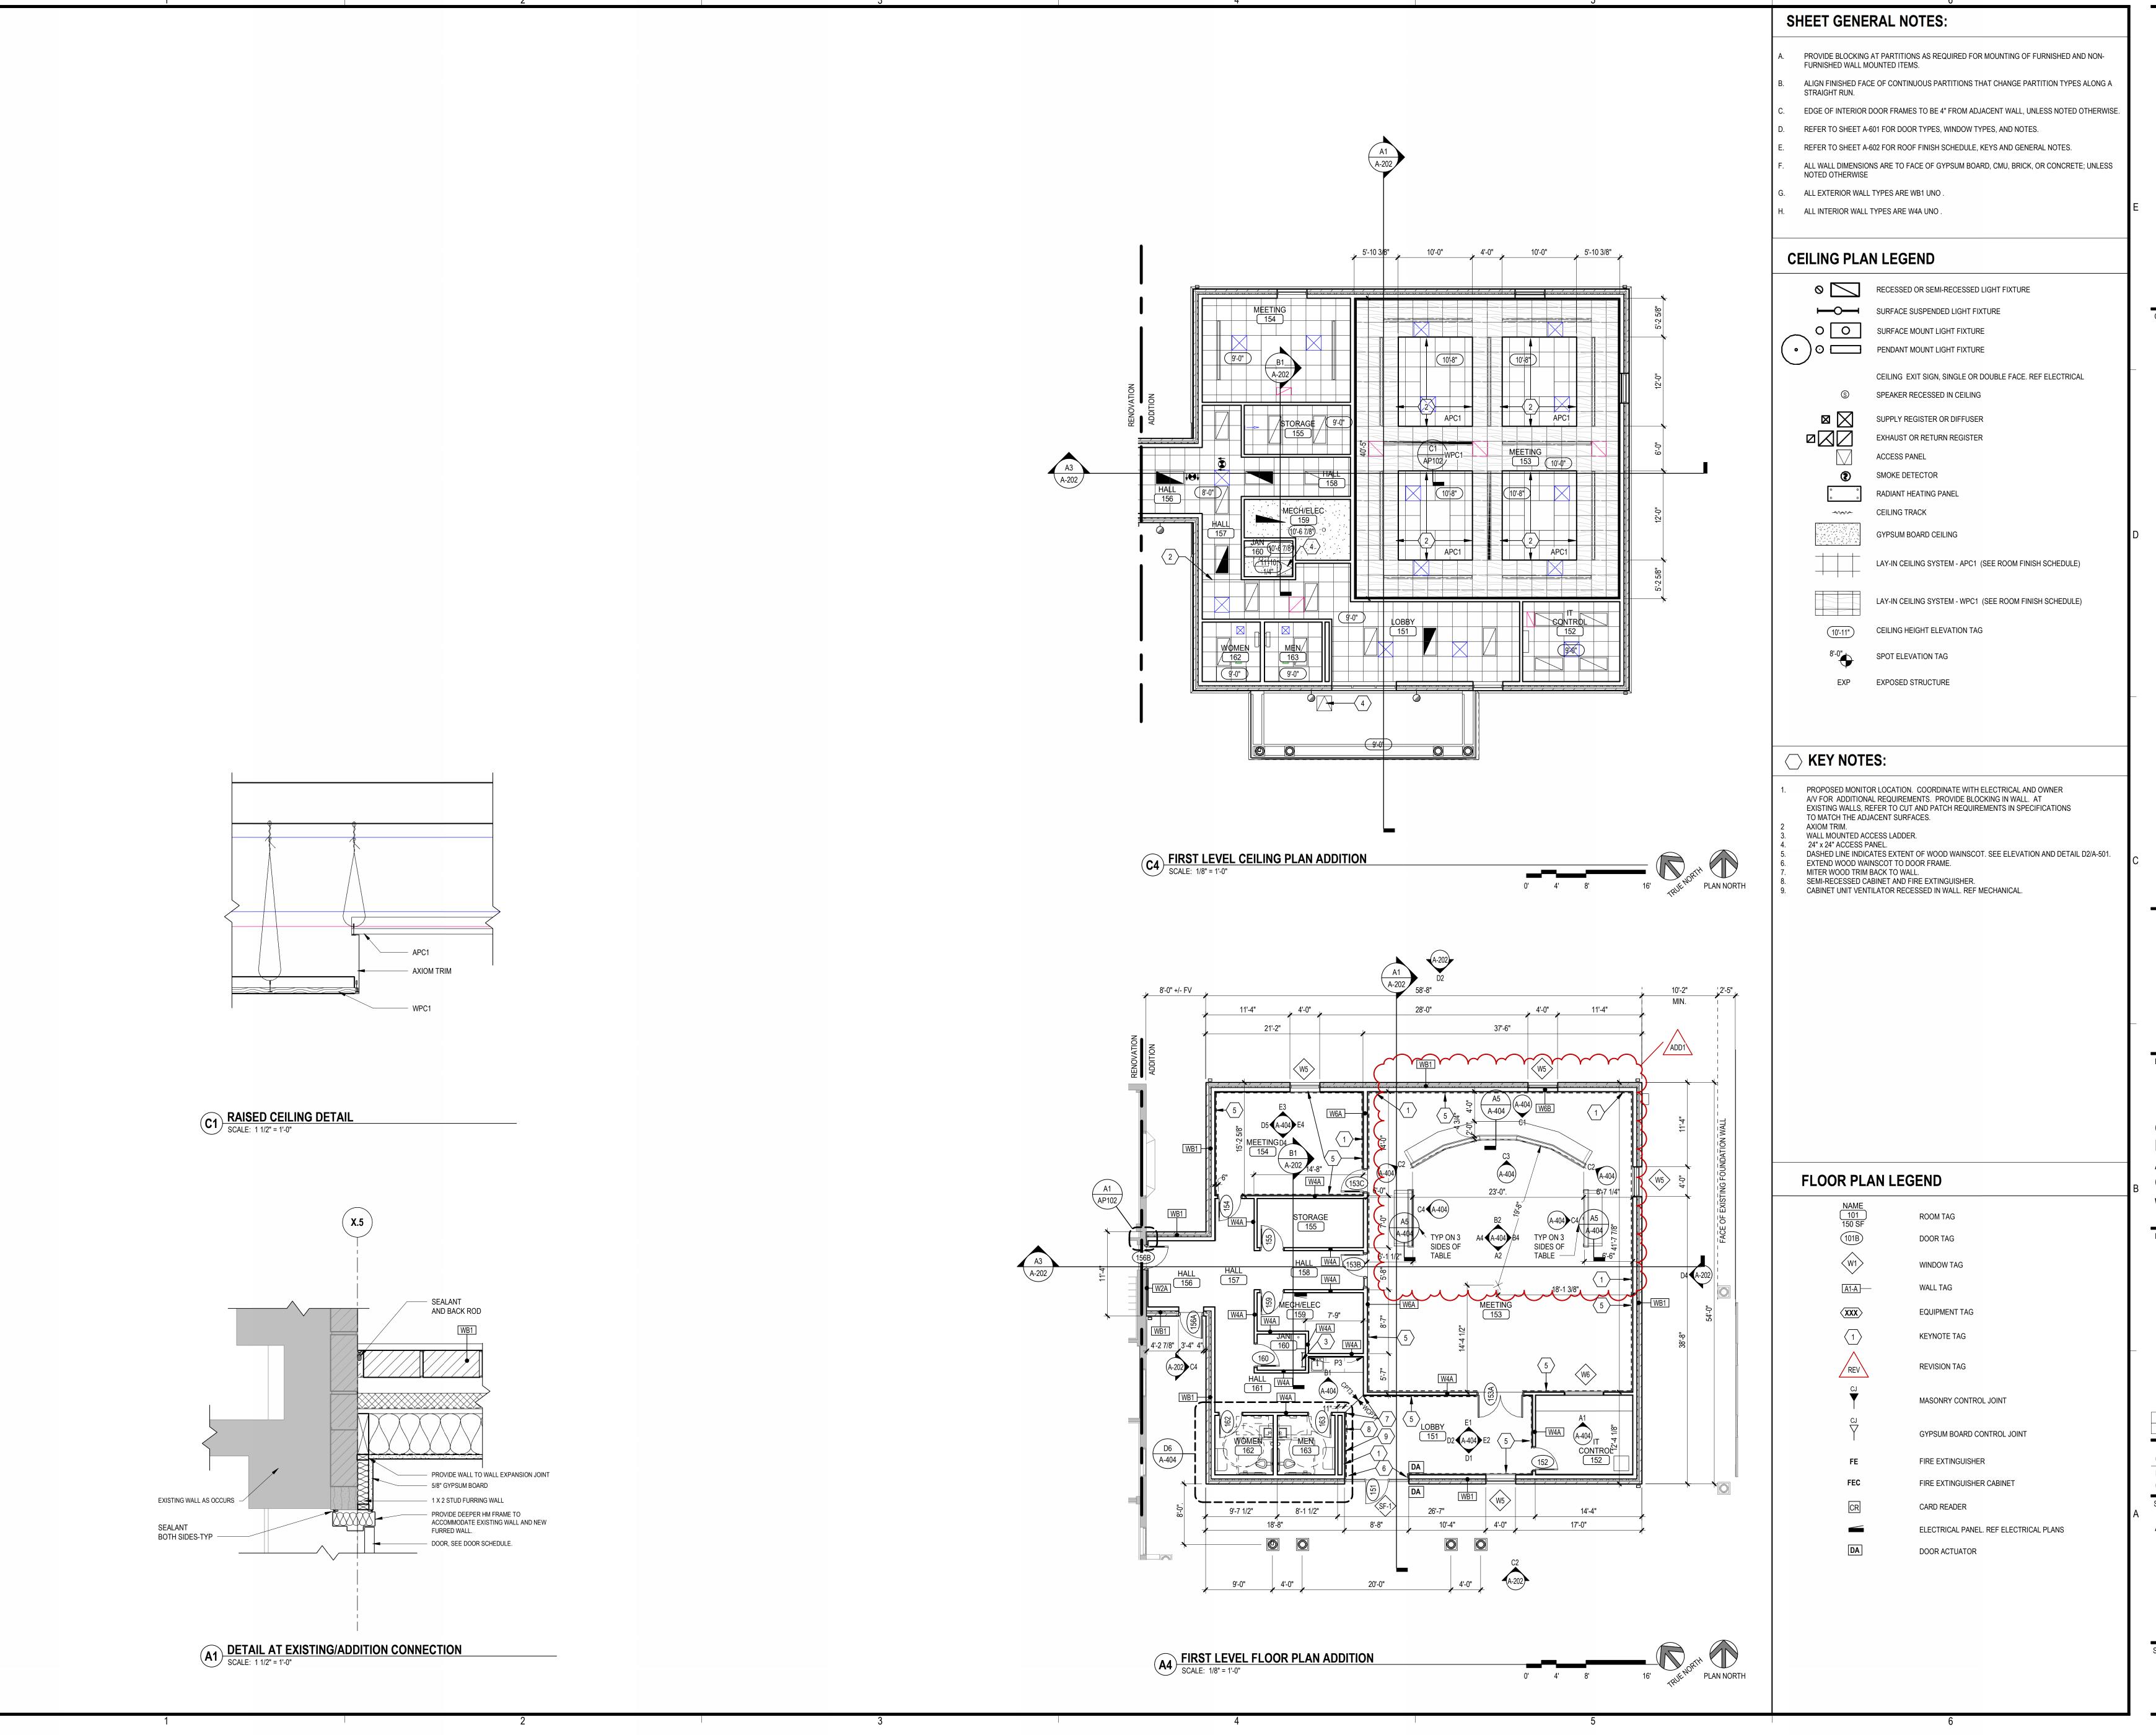

TSP

TSP, Inc. 14 W. Kemp Ave. Watertown, SD 57201

Watertown, SD 57201 (605) 884-7090

> Architecture Engineering Planning

www.teamtsp.com

CONSULTANTS

PATE: 02/23/2024

PROJECT TITLE

CITY OF WATERTOWN RENOVATION AND ADDITION FOR NEW CITY HALL WATERTOWN, SD

ADD1	03/05/2024	ADD1
ISSUE	DATE	DESCRIPTION
ISSUE DATE	DRAWN BY	
02/23/2024	BMO	
PROJECT # CHECKED BY		


09201051
SHEET TITLE

ADDITION FLOOR PLAN

SHEET NUMBER

\P102


@ TCD Inc 2024

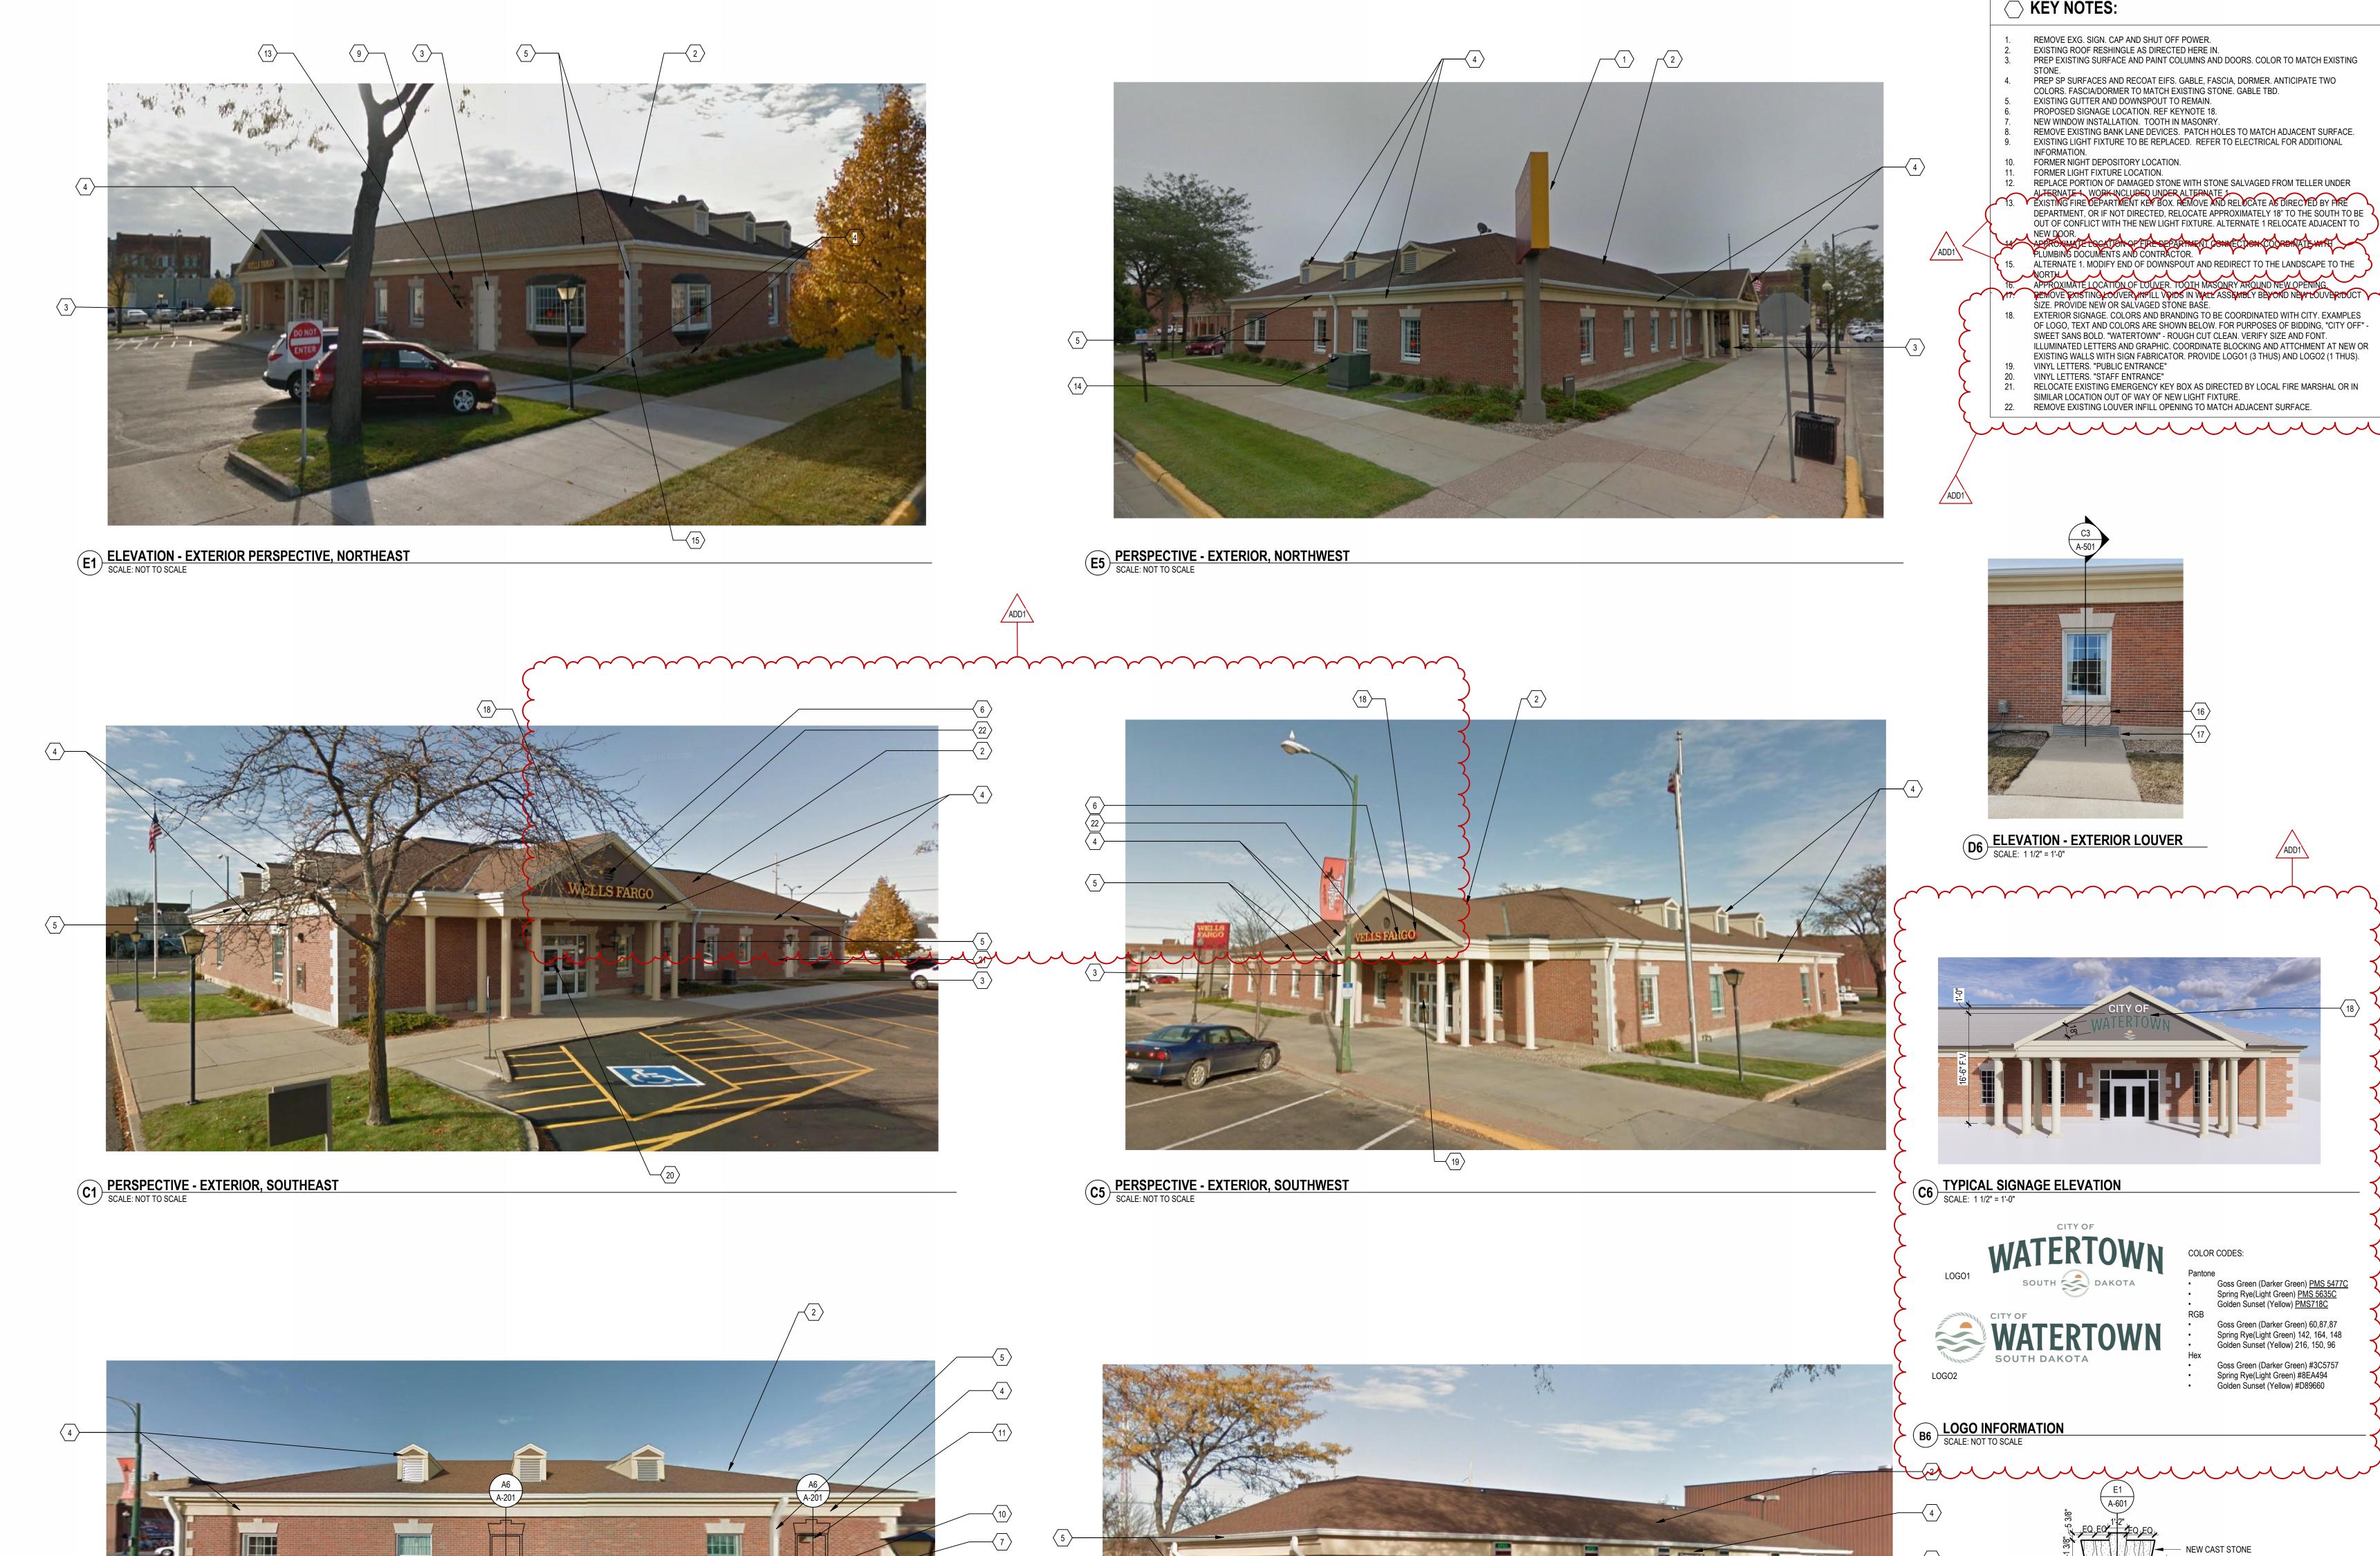



PERSPECTIVE - EXTERIOR TELLER, SOUTHWEST

SCALE: 3" = 1'-0"

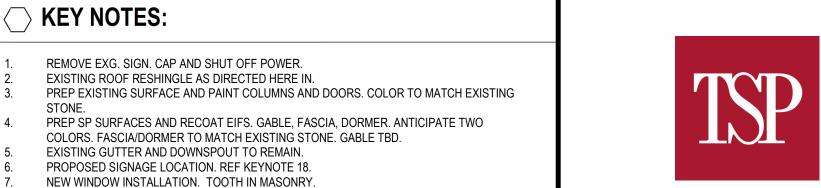

(605) 884-7090 www.teamtsp.com

> Architecture Engineering

CONSULTANTS

D6 ELEVATION - EXTERIOR LOUVER
SCALE: 1 1/2" = 1'-0"








Goss Green (Darker Green) PMS 5477C Spring Rye(Light Green) PMS 5635C Golden Sunset (Yellow) PMS718C

Goss Green (Darker Green) #3C5757
Spring Rye(Light Green) #8EA494
Golden Sunset (Yellow) #D89660

Goss Green (Darker Green) 60,87,87 Spring Rye(Light Green) 142, 164, 148 Golden Sunset (Yellow) 216, 150, 96

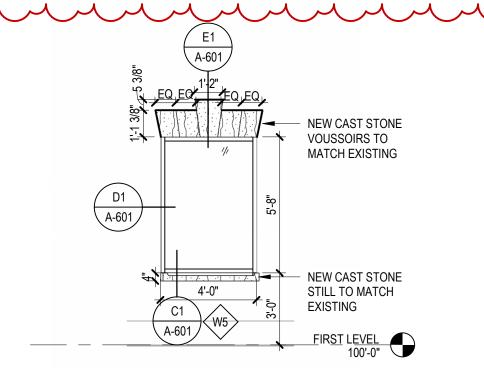

A6 ELEVATION, ENLARGED - WINDOW 5
SCALE: 1/4" = 1'-0"




PROJECT TITLE

ADD1 03/05/2024 ADD1 ISSUE DATE DESCRIPTION ISSUE DATE DRAWN BY

CHECKED BY PROJECT# SHEET TITLE

**EXTERIOR ELEVATIONS** 

PERSPECTIVE - EXTERIOR, SOUTH
SCALE: NOT TO SCALE

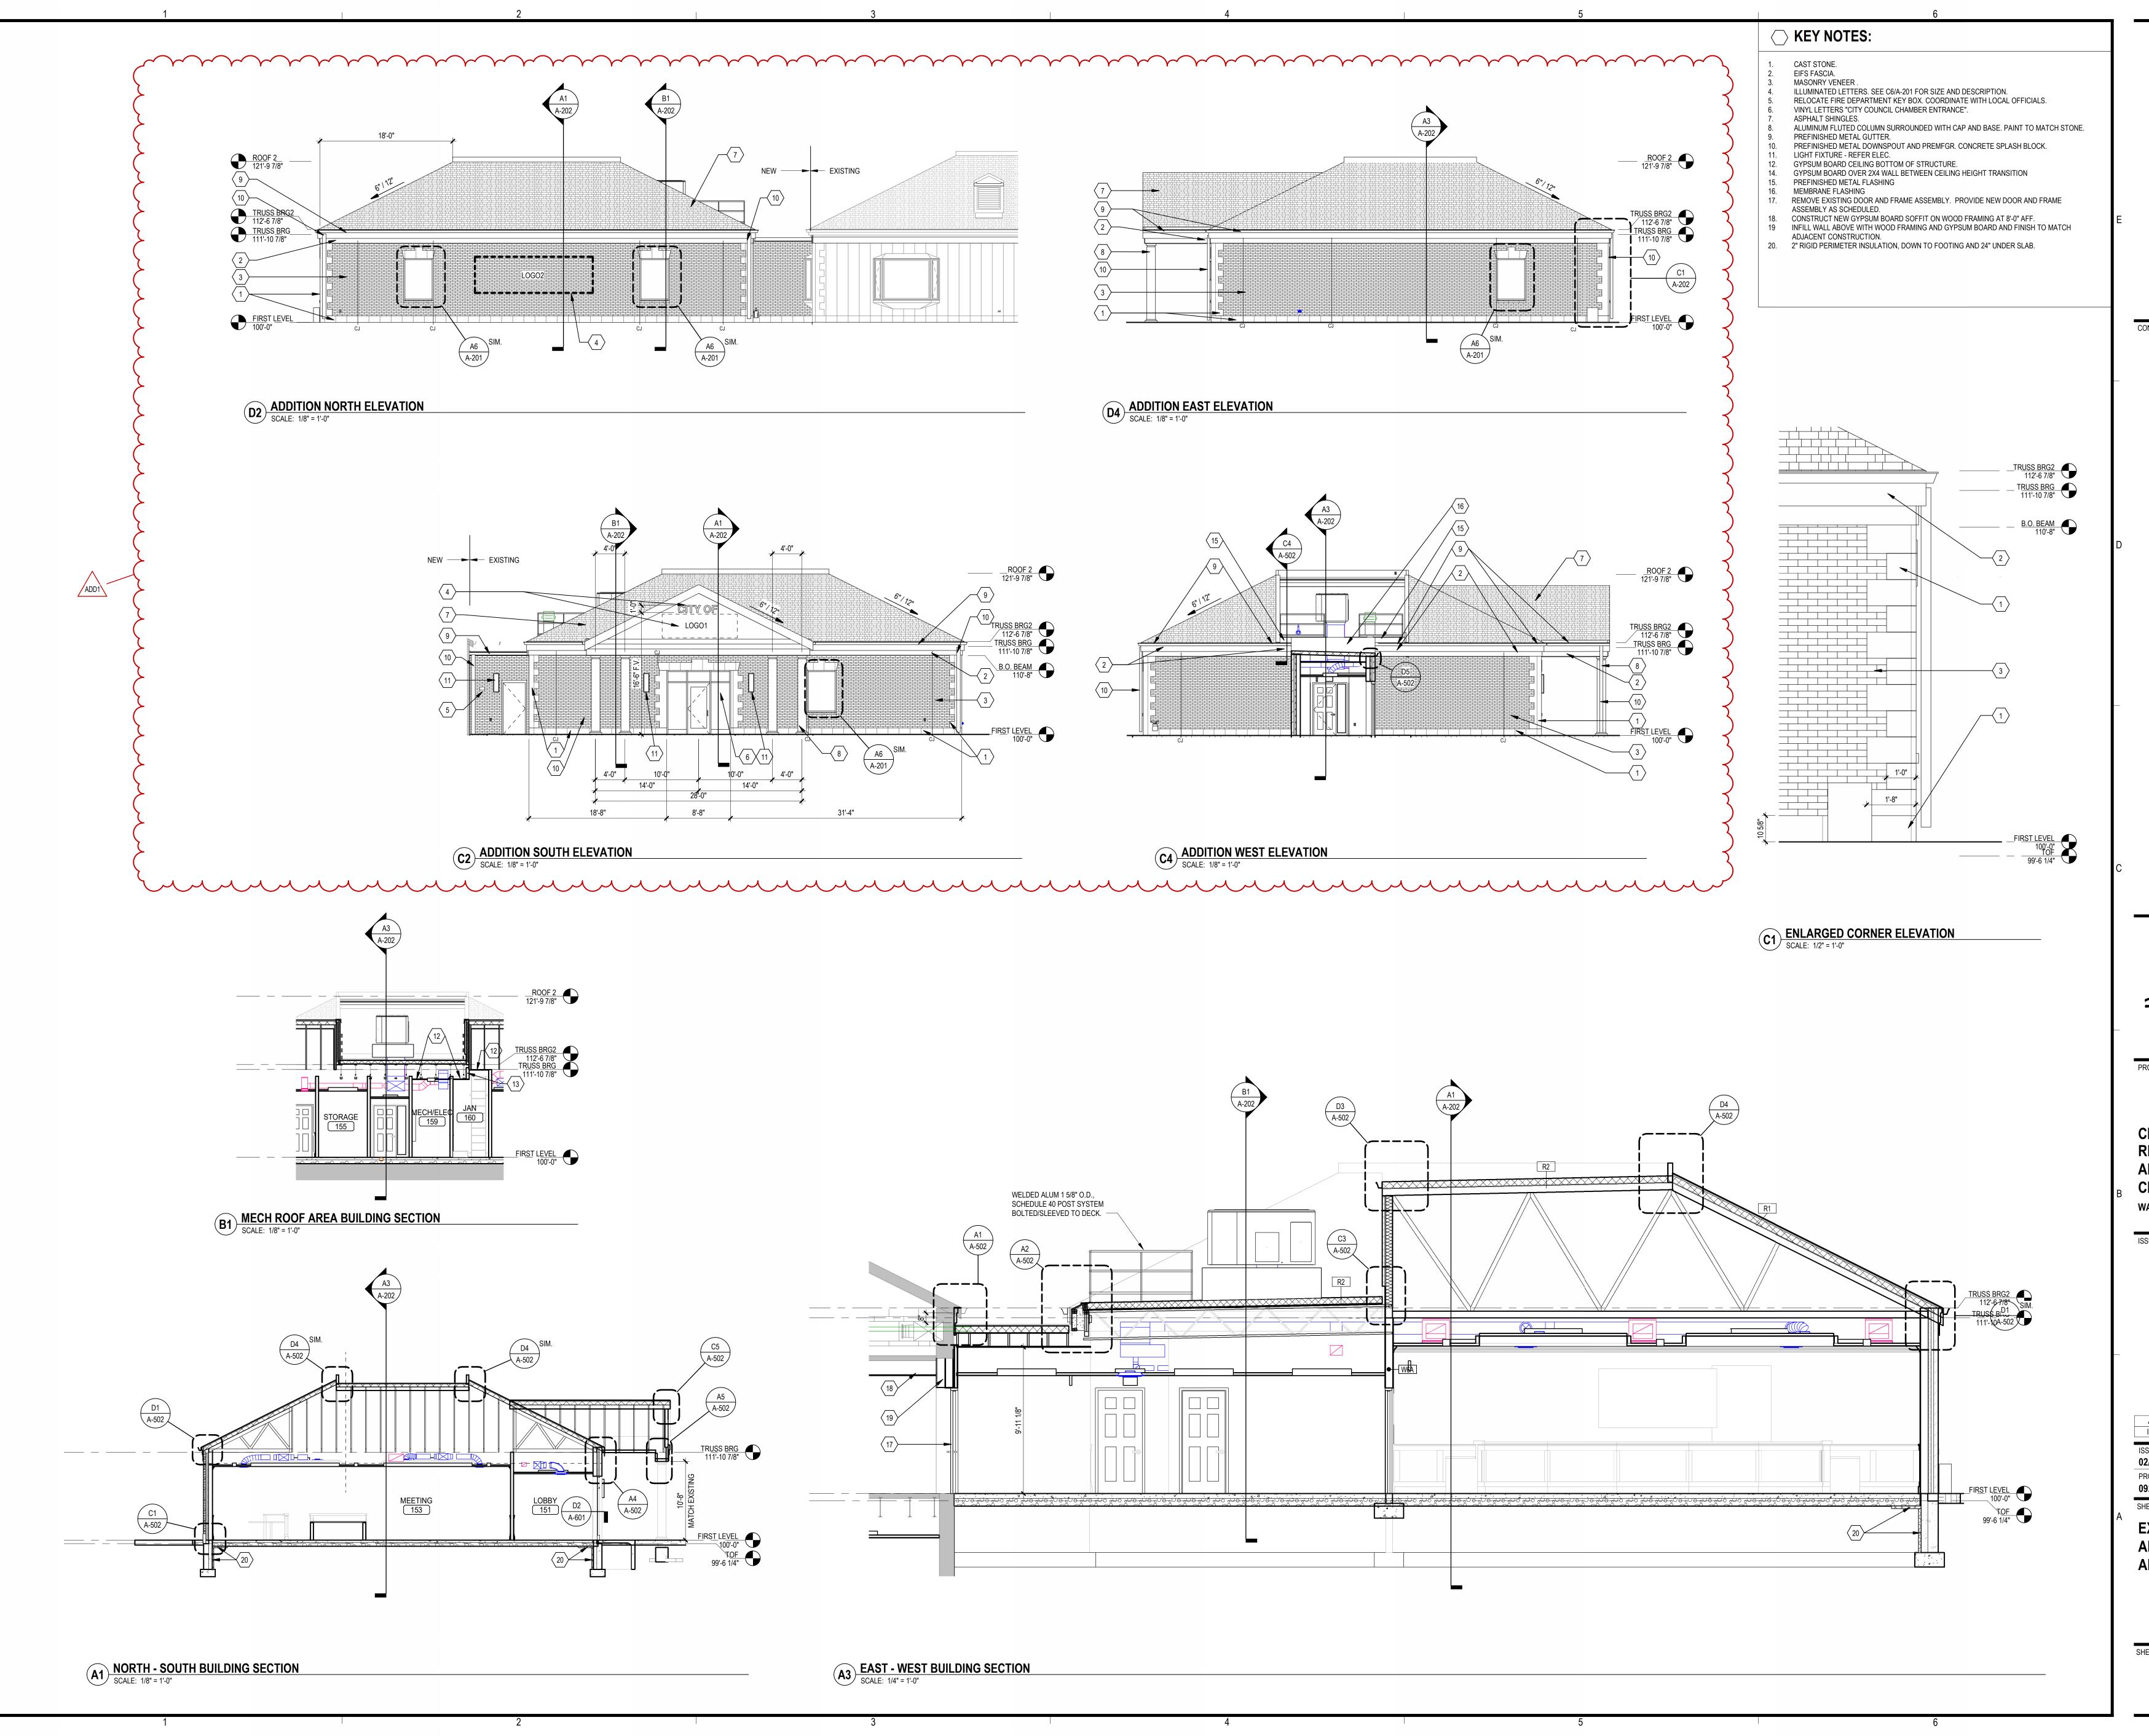

(605) 884-7090

www.teamtsp.com

Architecture Engineering

CONSULTANTS

**CITY OF WATERTOWN RENOVATION AND ADDITION FOR NEW CITY HALL** WATERTOWN, SD

ADD1 03/05/2024 ADD1
ISSUE DATE DESCRIPTION PROJECT# CHECKED BY

**EXTERIOR ELEVATIONS AND SECTIONS -ADDITION** 

SIGNAGE

SIGN TYPE 3: REGULATORY PANEL SIGNAGE, BASIS OF DESIGN, INPRO, BOSTON.

REFERENCE SPECIFICATIONS FOR LOCATIONS, 101423.23

munument.

	WINDOW SIZ	ZES FOR BLIND (	VERIFY IN FIELD)
	ROOM NAME	ROOM NUMBER	WINDOW SIZES
	OFFICE	032	ONE WINDOW AT 48" W X 3'9"H
	OFFICE	103	TWO WINDOWS AT 14"W X 5'8"H AND ONE WINDOW AT 3'W X 5'8"H
	OFFICE	104	TWO WINDOWS AT 14"W X 5'8"H AND ONE WINDOW AT 3'W X 5'8"H
	OFFICE	105	TWO WINDOWS AT 14"W X 5'8"H AND ONE WINDOW AT 3'W X 5'8"H
	OFFICE	106	TWO WINDOWS AT 14"W X 5'8"H AND ONE WINDOW AT 3'W X 5'8"H
	OFFICE	107	ONE WINDOW AT 14"W X 5'8"H, ONE WINDOW AT 3'W X 5'8"H, AND ONE WINDOW AT 4'W X 5'8"H.
	OFFICE	109	TWO WINDOWS AT 14"W X 5'8"H AND ONE WINDOW AT 3'W X 5'8"H
	OFFICE	110	ONE WINDOW AT 5'8"W X 5'8"H AND TWO WINDOWS AT 14"W X 5'8"H.
$\wedge$	OFFICE	111	ONE WINDOW AT 8'6"W X 5'8"H AND TWO WINDOWS AT 14"W X 5'8"H.
ADD1\	OFFICE	114	TWO EXTERIOR BAY WINDOWS WITH ONE SECTION AT 4'-8"W X 5'-6"H AND TWO SECTIONS AT 2'-2"W.
	OFFICE	116	TWO WINDOWS AT 14"W X 5'8"H AND ONE WINDOW AT 3'W X 5'8"H
	OFFICE	117	TWO WINDOWS AT 14"W X 5'8"H AND ONE WINDOW AT 3'W X 5'8"H
	OFFICE	118	TWO WINDOWS AT 14"W X 5'8"H AND ONE WINDOW AT 3'W X 5'8"H
	OFFICE	119	TWO WINDOWS AT 14"W X 5'8"H AND ONE WINDOW AT 3'W X 5'8"H

					AL LIMIS			/LL - C	BASE BID		
ROOM#	ROOM NAME	FLOOR	BASE	CEILING	NORTH	EAST	SOUTH	WEST	CABINET	SEWORK COUNTER	REMARKS
	ELEV1	CPT1	-	-	-	-	-	-	-	-	
	ST1	CPT1	-	P4	P1	P1	P1	P1	-	-	3
	ST2	LVT1	-	P4	P1	P1	P1	P1	-	-	4
001	STAIR	CPT3	WB1	P4/APC1	P1	P1	P1	P1	-	-	3
002	RR	PT1	-	APC1	PT2	PT3	PT3	PT3	-	-	
003	JANITOR	LVT1	VB1	APC1	P1/ FRP	P1	P1	P1/ FRP	PLAM1	SSM1	FULL HEIGHT FRP AT MOP SINK
004	WOMEN	PT1	-	APC1	PT3	PT2/PT3	PT3	PT3	-	-	5
004A	LACTATION	CPT2	VB1	APC1	P1	P1	P1	P3			
005	MEN	PT1	-	APC1	PT3	PT2/PT3	PT3	PT3	-	-	5
006A 008	STORAGE HALL	SC1	VB1 VB1	P4 APC1	P1 P1	P1 P1	P1 P1	P1 P1	-	-	*FRP1 4'W X 4'H AT MOP SINK
009B	HALL	CPT3	VB1	APC1	P1	P1	P1	P1	-	-	FREI 4 W X 4 H AT MOP SINK
009B	HALL	CPT3	VB1	APC1	P1	P1	P1	P1	-	<u>-</u>	
010	MECH	SC1	VB1	-	P1	P1	P1	P1			
012	DATA	SC1	VB1	-	P1	P1	P1	P1	-		
013	PRINTING	CPT2	VB1	APC1	P2	P1	P1	P1	PLAM1	PLAM2	
016	STORAGE	LVT1	VB1	APC1	P5	P5	P1	P1	-	-	
017	WORK ROOM	LVT1	VB1	APC1	P1	P1	P1	P1	PLAM1	PLAM2	
018	HALL	CPT3	VB1	APC1	P1	P1	-	P1	-	-	
019	OFFICE	CPT2	VB1	APC1	P1	P1	P1	P1			
020	STORAGE	SC1	VB1	APC1	P1	P1	P1	P1	-	-	
022	OFFICE	CPT2	VB1	APC1	P1	P1	P1	P1			
022A	MEETING	CPT2	WB1	APC1	P1/P3	P1/P3	P1/P3	P1/P3	-	-	5
022B	STOR	CPT2	VB1	APC1	P1	P1	P1	P1	-	-	
022C	STORAGE ALCOVE	CPT2	WB1	APC1	P1	P1	P1	P1	-	-	
023	STORAGE	CPT3	VB1	P4	P1	P1	P1	P1			
025	BREAK	CPT3	WB1	APC1	P1	P1	P1	P1	PLAM1	SSM1	
027	STORAGE	CPT3	VB1	APC1	P1	P1	P1	P1	-	-	
028	HALL	CPT3	VB1	APC1	P1	P1	P1	P1	-	-	
029	ELEVATOR	-	-	-	-	-	-	-	-	-	
	ROOM										
032	OFFICE	CPT2	VB1	APC1	P1	P1	P1	P1			
033	BREAK	LVT1	VB1	APC1	P1	P1	P1	P1			
034	OPEN OFFICE	LVT1	VB1	APC1	P1	P1	P1	P1		SSM1	
<b>101 Y</b>	LOBBY	PT1	WB1	EXIST/ P4	P1/PT4	P1/PT4	P1/PT4	P1 P1	-	QTZ1	SEE ELEVATIONS FOR DESK FRONTS, 5
101A 101B	VEST VEST	WCPT1	WB1 WB1	P4 P4	P1 P1	P1 P1	P1 P1	P1	-	-	
101B 102	OPEN OFFICE	CPT1	VVBI	EXIST/ P4	PI	P1	P1	P1	-	QTZ1	
102A	HALL	CPT2	EXISTING	P4	1-	P1	P1	P1	-	QIZI	
102R	HALL	CPT2	EXISITING	P4	P1	P1	-	P1	-	-	
102C	HALL	CPT2	EXISTING	P4	-	P1	P1	P1	-	-	
103	OFFICE	CPT2	WB1	P4	P1	P1	P1	P2	-	-	1
104	OFFICE	CPT2	WB1	P4	P1	P1	P1	P2	-	-	1
105	OFFICE	CPT2	WB1	P4	P1	P1	P1	P2	-	-	1
106	OFFICE	CPT2	WB1	P4	P1	P1	P1	P2	-	-	1
107	MEETING	CPT2	WB1	P4	P1	P1	P1	P2	-	-	2
108	OFFICE	CPT2	WB1	P4	P1	P1	P1	P1	-	-	
109	OFFICE	CPT2	WB1	P4	P1	P1	P1	P1	-	- (	1 3
110	OFFICE	CPT2	WB1	P4	P1	P1	P1	P1	-	-	
111	OFFICE	CPT2	WB1	P4	P1	P1	P1	P1	-	-	1
112	RR	PT1 PT1	- W/D4	P4	PT3	PT2	PT3 P1	PT3	- DLAM4	- CCM4	
113 114	ALCOVE OFFICE	CPT2	WB1 WB1	P4	P1 P1	P1 P1	P1	P1 P2	PLAM1	SSM1	1
115	STAIR	LVT1	VB1	P4	P1	P1	P1	P1	-	-	4
116	OFFICE	CPT2	WB1	P4	P1	P2	P1	P1	PLAM1	PLAM4	1
117	OFFICE	CPT2	WB1	P4	P1	P2	P1	P1			1
118	OFFICE	CPT2	WB1	P4	P1	P2	P1	P1	-	-	1
119	MEETING	CPT2	WB1	P4	P1	P2	P1	P1	-	-	2
120	OPEN OFFICE	CPT2	WB1	APC1	P1	P1	P1	P1	PLAM1	QTZ1	1 (EXTERIOR WINDOWS ONLY)
121	WORK	CPT2	WB1	P4	P1	P1	P1	P1	PLAM1	PLAM2	, , , , , , , , , , , , , , , , , , , ,
122	OFFICE	CPT2	WB1	P4	P1	P1	P2	P1	-	-	1
123	OFFICE	CPT2	WB1	P4	P1	P1	P2	P1			1
124	OFFICE	CPT2	WB1	P4	P1	P1	P2	P1	-	-	1

				RO	OM FIN	ISH SC	HEDU	ILE - /	ALT #1		
						WAL	LS		CASI	EWORK	
ROOM #	ROOM NAME	FLOOR	BASE	CEILING	NORTH	EAST	SOUTH	WEST	CABINET	COUNTER	REMARKS
131	STOR	SC1	-	-	P1	P1	P1	P1	-	-	-

				R	OOM FI	NISH SC	CHEDUL	E - ADI	DITION		
						WA	LLS		CAS	EWORK	
ROOM #	ROOM NAME	FLOOR	BASE	CEILING	NORTH	EAST	SOUTH	WEST	CABINET	COUNTER	REMARKS
151	LOBBY	WCPT1	WB1	APC1	PT4/P1	PT4/P1	PT4/P1	PT4/P1	-	-	5
152	IT CONTROL	CPT3	VB1	APC1	P1	P1	P1	P1	-	PLAM2	
153	MEETING	CPT1	WB1	WPC1/APC1	WD2/VWC1	WD2/VWC1	WD2/VWC1	WD2/VWC1	-	-	5, 6
154	MEETING	CPT1	WB1	APC1	WD2/VWC1	WD2/VWC1	WD2/VWC1	WD2/VWC1	-	-	5, 6
155	STORAGE	SC1	VB1	P4	P1	P1	P1	P1	-	-	
156	HALL	CPT3	WB1	APC1	P1	P1	P1	P1	-	-	
157	HALL	CPT3	WB1	APC1	P1	P1	P1	P1	-	-	
158	HALL	CPT3	WB1	APC1	P1	P1	P1	P1	-	-	
159	MECH/ELEC	SC1	VB1	P4	P1	P1	P1	P1	-	-	
160	JAN	SC1	VB1	P4	P1	P1/ FRP1*	P1/ FRP1*	P1			*INCLUDE FRP1 4'H X 4'W AT MOP SINK
161	HALL	CPT3	WB1	APC1	P1/P3	P1	P1	P1	PLAM1	SSM1	5
162	WOMEN	PT1	-	APC1	PT3	PT2	PT3	PT3	-	-	
163	MEN	PT1	-	APC1	PT3	PT3	PT3	PT2	-	-	

				FINISH	KEY	
CODE	DESCRIPTION	MANUFACTURER	PATTERN	COLOR	NUMBERS	COMMENTS
RS1	MANUAL ROLLER SHADES	HUNTER DOUGLAS	ROLLER SHADES FR - LIGHT BLOCKING	TBD		
FRP	FIRERCLASS REINFORCED PANELS			WHITE		FULL HEIGHT
B1	WINDOW BLINDS	HUNTER DOUGLAS	DUETTE FR HONEYCOMB SHADES - SEMI OPAQUE	TBD TO TO		
B2 .	WINDOW BLINDS	HUNTER DOUGLAS.	DUETTE FR HONEYCOMB SHADES - OPAQUE	TBD		
S4-/	SIGNACE	INPRO	SIGNS SAPE BOSTON	TRD TO THE TREE TREE TO THE TREE TREE TO THE TREE TREE TREE TO THE TREE TREE TREE TREE TREE TREE TREE		
PT1	PORCELAIN TILE 12X24	FLORIDA TILE	DIVINITY	HORIZON		INSTALL IN HORIZONTAL STAGGERED PATTERN
PTB1	PORCELAIN TILE BASE	FLORIDA TILE	DIVINITY	DAWN	4" CUT TILE PIECE WITH SCHLUTER JOLLY TRIM	
PT2	PORCELAIN TILE LINEAR MOSAIC	FLORIDA TILE	DIVINITY	DAWN		INSTALL HORIZONTALLY
PT3	PORCELAIN TILE WALLS 12X24	FLORIDA TILE	DIVINITY	DAWN		INSTALL IN HORIZONTAL STAGGERED PATTERN
PT4	PORCEALIN TILE DESK FRONTS	IRIS MAX FINE	ONICE	GRIGIO	LARGE FORMAT TILE, SIZED TO REDUCE WASTE, NO SEAMS PER INSET	
CPT1	CARPET TILE	MANNINGTON	HAZE	RAVINE	OPEN OFFICE & CHAMBER	
CPT2	CARPET TILE	MANNINGTON	COAST	VISTA	PRIVATE OFFICES	
CPT3	OARPET TICE	MANNINGTON	DRIFT	VISTA	CIRCULATION	
WCPT1	WALK OFF CARPET TILE	MANNINGTON	FRIXTION, FORCE	VECTOR	-)	
LVT4	LUXURX VINYL THE 12X18	MANNINGTON	SPACIA STONE	LINEAR STONE SHALE		
VSN1	VINYL STAIR NOSING FOR CARPET	JOHNSONITE	REFERENCE SPECIFICATIONS	TO MATCH VINYL BASE	-	-
VSN2	VINYL STAIR NOSING FOR LVT	JOHNSONITE	REFERENCE SPECIFICATIONS	TO MATCH VINYL BASE	-	-
VB1	VINYL BASE	JOHNSONITE	4" TRADITIONAL COVED VINYL BASE	PEBBLE		
WB1	WOOD BASE	REFERENCE SPECIFICATIONS	TO MATCH EXISTING IN PROFILE	TBD		
WD1	WOOD	REFERENCE SPECIFICATIONS	-	STAINED TO MATCH EXISTING		
WD2	WOOD	REFERENCE SPECIFICATIONS	-	STAINED TO MATCH PLAM1		
P1	PAINT - MAIN NEUTRAL	SHERWIN WILLIAMS	-	NEUTRAL GROUND		
P2	PAINT - ACCENT	SHERWIN WILLIAMS	-	STUDIO BLUE GREEN	ACCENT COLOR IN OFFICES	
P3	PAINT - ACCENT	SHERWIN WILLIAMS	-	TEMPE STAR		
P4	PAINT - CEILINGS	SHERWIN WILLIAMS	-	ALABASTER	-	
P5	PAINT - ACCENT	SHERWIN WILLIAMS	-	STUDIO TAUPE		
VWC1	VINYL WALL COVERING	MOMENTUM	WANDERLUST	TBD	-	PRELIMINARY SELECTION IS SPARROW, FINAL APPROVAL NEEDED
APC1	ACOUSTICAL CEILING PLANELS 24"X24"	' ARMSTRONG	ULTIMA HIGH NRC, BEVELED TEGULAR	WHITE		
WPC1	WOOD PANEL CEILING	ARMSTRONG	WOOD WORKS TEGULAR PANELS	LIGHT CHERRY	CHAMBERS CEILING ACCENT	
PLAM1	PLASTIC LAMINATE	WILSONART	-	SHAKER CHERRY	CASEWORK	
PLAM2	PLASTIC LAMINATE	WILSONART	-	NATURAL COTTON	COUNTERTOPS	
PLAM3	PLASTIC LAMINATE	WILSONART	-	SHADOW	NOT USED	
PLAM4	PLASTIC LAMINATE	TBD	-	TBD	-	TO MATCH LAMINATE ON FURNITURE WORKSURFACE
QTZ1	QUARTZ COUNTERTOP	VIATERA	-	NATURAL LIMESTONE	COUNTERTOPS	
SSM1	SOLID SURFACE MATERIAL	CORIAN	-	ARTISTA CANVAS	COUNTERTOPS	

# ROOM FINISH SCHEDULE GENERAL NOTES

- 1 PAINT ALL EXPOSED STRUCTURE. U.N.O.
  2 ALL EXISTING WOOD PANELING AND WOOD BASE TO
  REMAIN. WHERE (WB1) WOOD BASE IS INDICATED, ONLY
  INSTALL NEW BASE ON NEW WALLS AS NEEDED OR WHERE
  THERE IS NO EXISTING WOOD BASE.
- 3 INCLUDE PROPER FLOORING TRANSITIONS WHERE
- NEEDED.
  4. DO NOT PAINT ANY EXISTING WOOD TRIM OR PANELING.

# ROOM FINISH SCHEDULE REMARKS

- INCLUDE (B1) WINDOW BLINDS ON ALL INTERIOR AND EXTERIOR WINDOWS IN ROOMS INDICATED.
   INCLUDE (B2) WINDOW BLINDS ON ALL INTERIOR AND
- EXTERIOR WINDOWS IN ROOMS INDICATED.

  3. INCLUDE VINYL STAIR NOSING (VSN1) FOR CARPET ON STAIRS

  4. INCLUDE VINYL STAIR NOSING (VSN2) FOR LVT ON
- STAIRS.

  5. REFERENCE FLOOR PLAN AND ELEVATIONS WHERE MULTIPLE FINISHES OCCUR ON ONE WALL.
- MULTIPLE FINISHES OCCUR ON ONE WALL.

  6. INCLUDE (RS1) MANUAL ROLLER SHADES ON ALL EXTERIOR WINDOWS IN ROOM.

# STANDARD INTERIOR ABBREVIATIONS

<u>,</u>	STANDARD INTE	LRION ADDREVIATIONS
	APC AWP BCMU CG CMU CONC CPT CT DCMU EP EPF FRP GLT GWB	ACOUSTICAL PANEL CEILING 2X4 ACOUSTICAL WALL PANEL BURNISHED CONCRETE MASONRY UNIT CORNER GUARD CONCRETE MASONRY UNIT CONCRETE CARPET CERAMIC TILE DECORATIVE CONCRETE MASONRY UNITS EPOXY PAINT EPOXY FLOORING FIBERGLASS REINFORCED PANEL GLASS TILE GROUT GYPSUM WALL BOARD
	GWB LVT	LUXURY VINYL TILE
1	MB MPC	METAL BASE METAL PANEL CEILING PAINT
     	PCONC PLAM PT PTB QT QTB	POLISHED CONCRETE PLASTIC LAMINATE PORCELAIN TILE PORCELAIN TILE BASE QUARRY TILE OUARRY TILE BASE
	RAF RBR RBRT RBRS RSTA RP SCONC SCMU SSM ST	RESILIENT ATHLETIC FLOORING RUBBER FLOORING RUBBER TILE FLOORING RUBBER SHEET FLOORING RUBBER STAIR TREAD / NOSING RESINOUS PANEL SEALED CONCRETE SPLITFACED CONCRETE MASONRY UNIT SOLID SURFACE MATERIAL STAIN
	STCONC SVF	STAINED CONCRETE SHEET VINYL FLOORING

TERRAZZO RESILIENT BASE

WOOD BASE

VINYL COMPOSITION TILE VINYL WALL COVERING

WALK-OFF CARPET TILE WALL PROTECTION WOOD PANEL CEILING WALL GUARD




TSP, Inc. 14 W. Kemp Ave. Watertown, SD 57201

> Architecture Engineering Planning

(605) 884-7090

www.teamtsp.com

CONSULTANTS

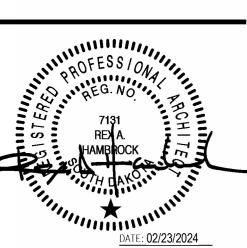

ROJECT TITLE

CITY OF WATERTOWN RENOVATION AND ADDITION FOR NEW CITY HALL WATERTOWN, SD

ADD1	03/05/2024	ADD1	
ISSUE	DATE	DESCRIPTION	
SSUE DATE		DRAWN BY	
02/23/2024	4	EMV	
PROJECT#		CHECKED BY	(

ET TITLE


ROOM FINISH SCHEDULE & SIGNAGE

ET NUMBER

**\-602** 

1-002

L:\\_TSP Revit Local\09201051-Watertown Cit

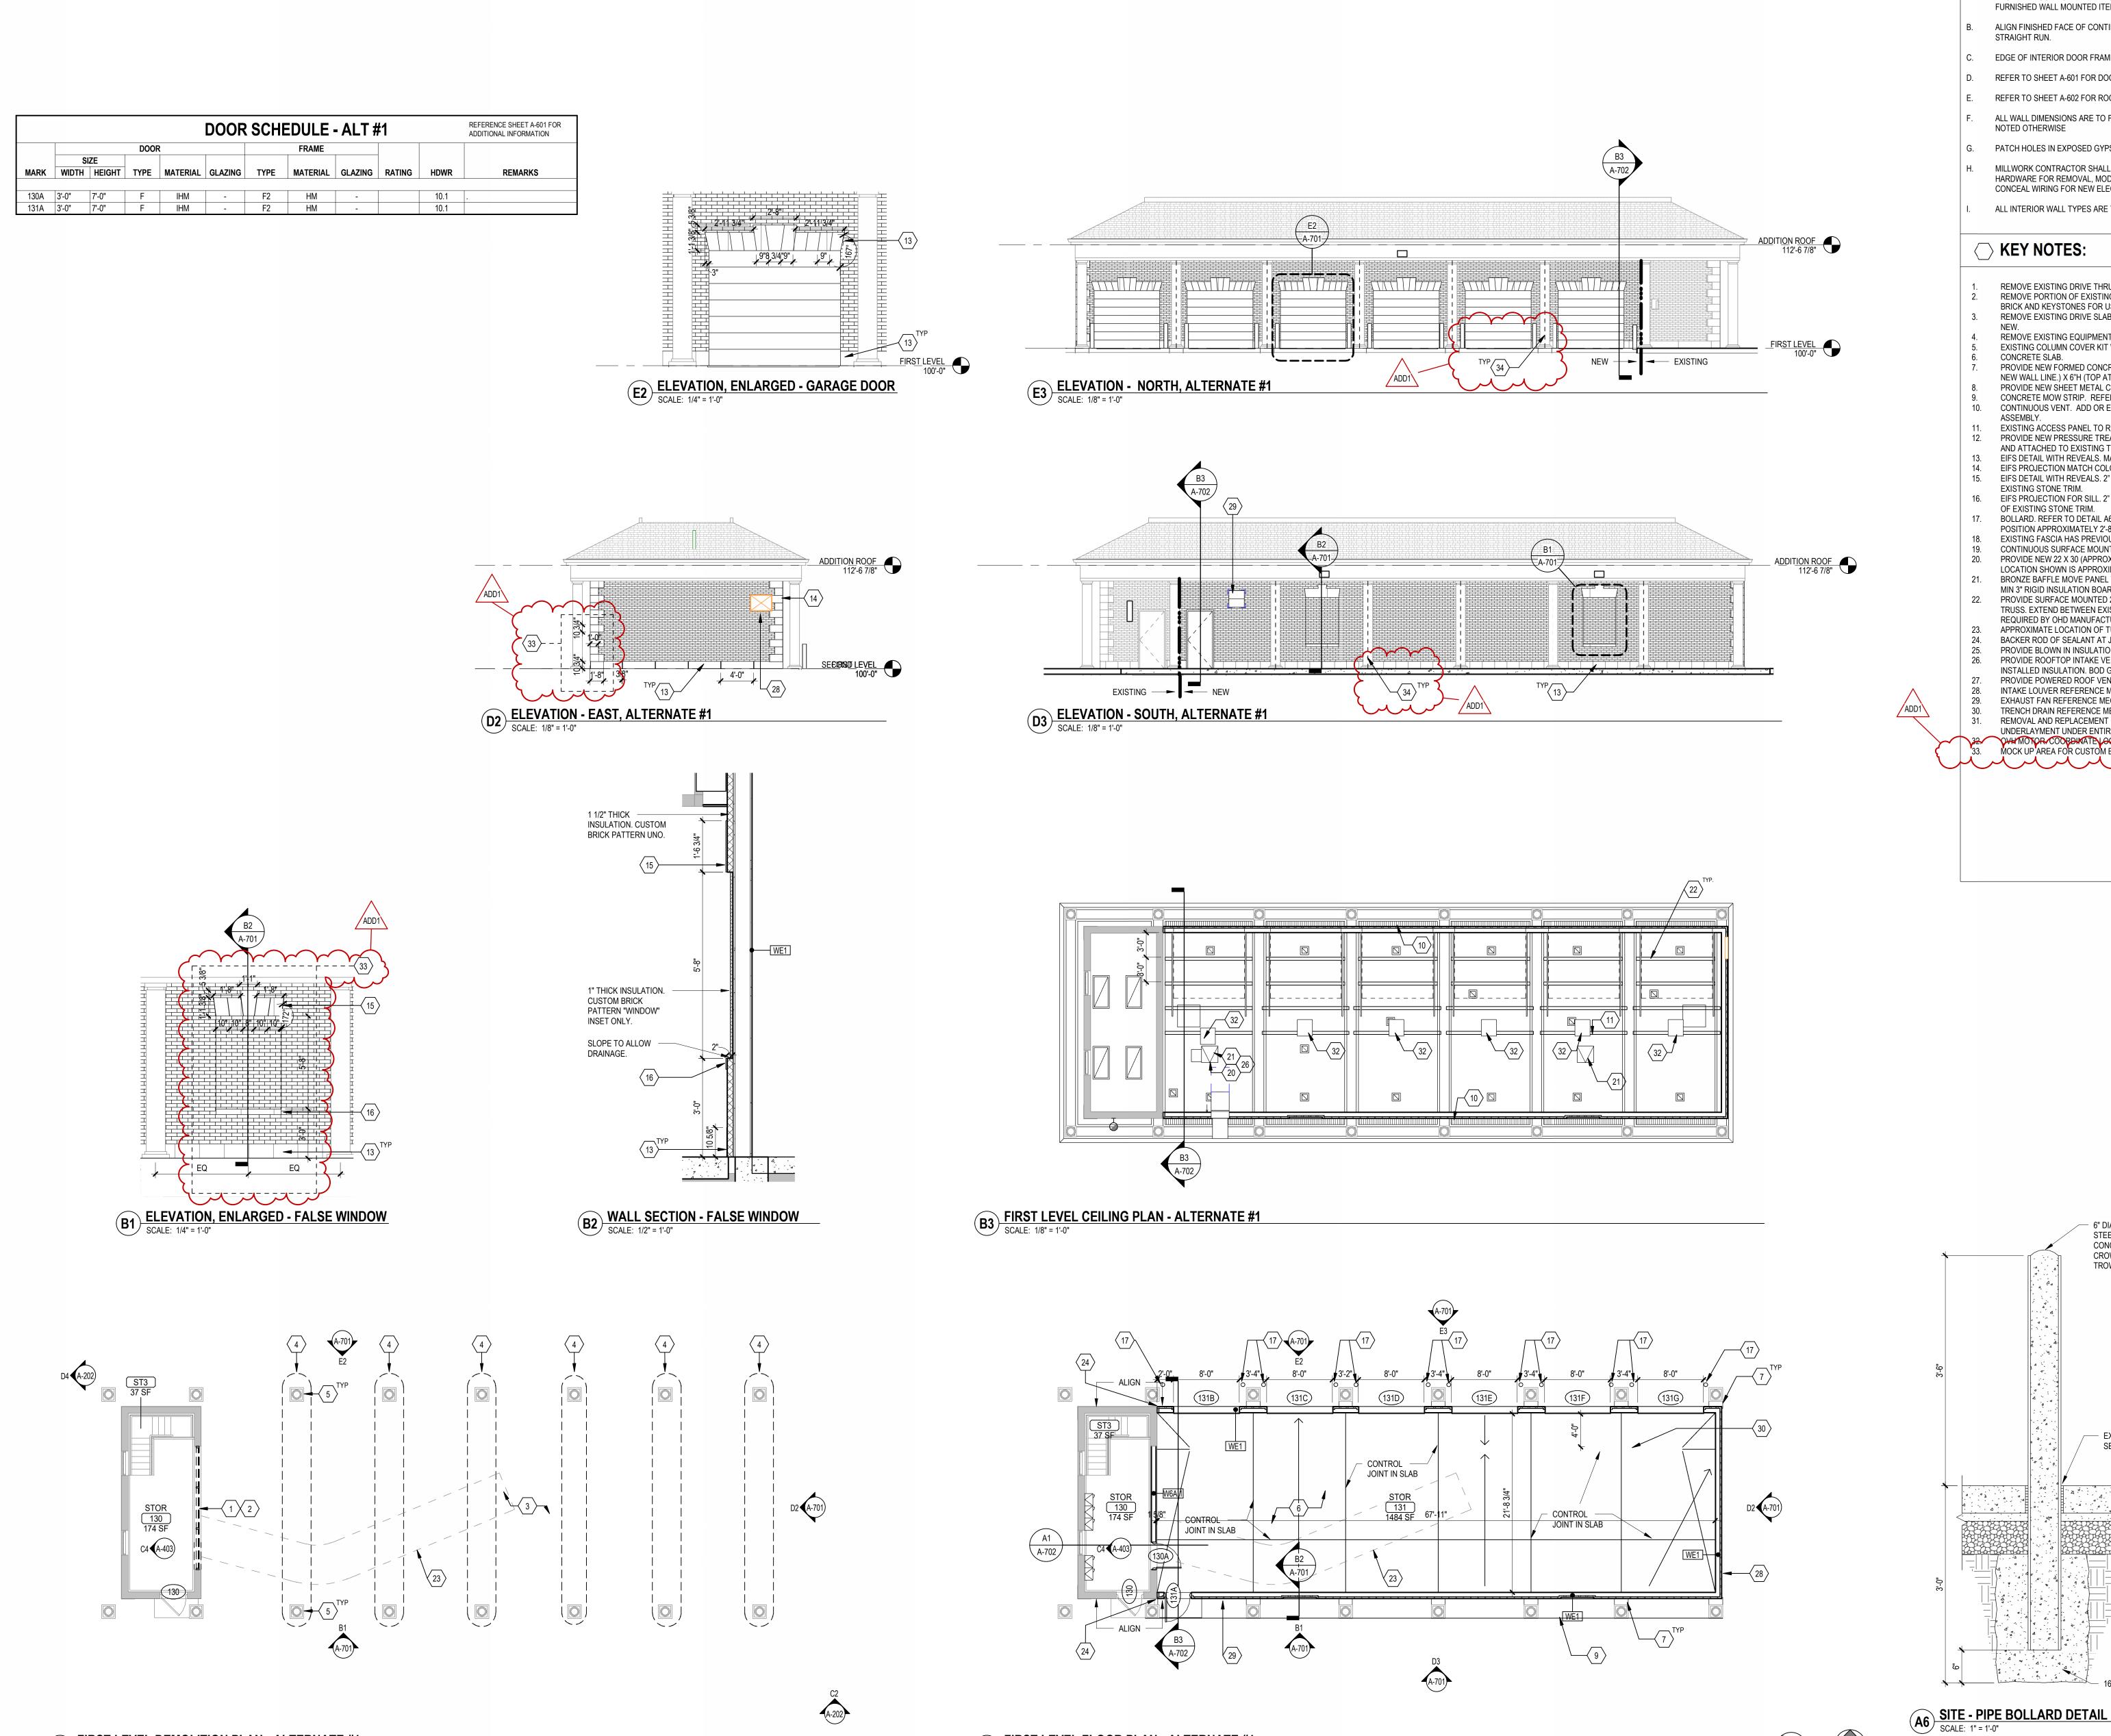

FIRST LEVEL FLOOR PLAN - ALTERNATE #1

SCALE: 1/8" = 1'-0"

FIRST LEVEL DEMOLITION PLAN - ALTERNATE #1

SCALE: 1/8" = 1'-0"

**SHEET GENERAL NOTES:** 

- PROVIDE BLOCKING AT PARTITIONS AS REQUIRED FOR MOUNTING OF FURNISHED AND NON-FURNISHED WALL MOUNTED ITEMS.
- ALIGN FINISHED FACE OF CONTINUOUS PARTITIONS THAT CHANGE PARTITION TYPES ALONG A
- EDGE OF INTERIOR DOOR FRAMES TO BE 4" FROM ADJACENT WALL, UNLESS NOTED OTHERWISE.
- REFER TO SHEET A-601 FOR DOOR TYPES, WINDOW TYPES, AND NOTES.
- REFER TO SHEET A-602 FOR ROOF FINISH SCHEDULE, KEYS AND GENERAL NOTES.
- ALL WALL DIMENSIONS ARE TO FACE OF GYPSUM BOARD, CMU, BRICK, OR CONCRETE; UNLESS NOTED OTHERWISE
- PATCH HOLES IN EXPOSED GYPSUM BOARD SURFACES TO REMAIN.
- MILLWORK CONTRACTOR SHALL COORDINATE WITH ELECTRICAL CONTRACTOR AND DOOR HARDWARE FOR REMOVAL, MODIFICATION, AND REINSTALLATION OF EXISTING WOOD TRIM TO CONCEAL WIRING FOR NEW ELECTRIFIED DEVICES.
- ALL INTERIOR WALL TYPES ARE TYPE W4A UNO.

**◯ KEY NOTES:** 

- REMOVE EXISTING DRIVE THRU TELLER UNIT. REMOVE PORTION OF EXISTING MASONRY AROUND/BELOW DRIVE THRU UNIT. SALVAGE BRICK AND KEYSTONES FOR USE AS INFILL ON PROJECT.
- REMOVE EXISTING DRIVE SLAB AND ADJACENT PAVING AS REQUIRED FOR INSTALLATION OF REMOVE EXISTING EQUIPMENT CURBS.
- EXISTING COLUMN COVER KIT WITH BASE AND CAP TO REMAIN. TYPICAL AT ALL COLUMNS. CONCRETE SLAB. PROVIDE NEW FORMED CONCRETE PIER CAP. APPROXIMATELY 20"W X 30"L (EXTEND TO
- NEW WALL LINE.) X 6"H (TOP AT EXISTING COLUMN COVER BEARING). PROVIDE NEW SHEET METAL CLOSURE TRIM.
- CONCRETE MOW STRIP. REFER TO SITE DRAWINGS. 10. CONTINUOUS VENT. ADD OR ENLARGE EXISTING OPENING IN CONFLICT WITH NEW WALL
- EXISTING ACCESS PANEL TO REMAIN. PROVIDE NEW PRESSURE TREATED 2x BLOCKING SURFACE MOUNTED, PERPENDICULAR
- AND ATTACHED TO EXISTING TRUSSES TO SUPPORT NEW OVERHEAD DOOR HANGERS. EIFS DETAIL WITH REVEALS. MATCH COLOR AND PROFILE OF EXISTING STONE TRIM.
- 14. EIFS PROJECTION MATCH COLOR AND PROFILE OF EXISTING STONE QUOIN. 15. EIFS DETAIL WITH REVEALS. 2" THICK INSULATION. MATCH COLOR AND PROFILE OF
- EXISTING STONE TRIM. 16. EIFS PROJECTION FOR SILL. 2" THICK INSULATION. TOP, ENDS AND FACE TO MATCH COLOR OF EXISTING STONE TRIM.
- BOLLARD. REFER TO DETAIL A6/A-701. ALIGN EDGE OF OLLARD WITH JAMB OF DOOR. POSITION APPROXIMATELY 2'-8" FROM FACE OF WALL TO CENTERLINE OF POST.
- EXISTING FASCIA HAS PREVIOUSLY BEEN COVERED WITH EIFS. TYPICAL. CONTINUOUS SURFACE MOUNTED BLOCKING FOR OVERHEAD DOOR TRACK.
- PROVIDE NEW 22 X 30 (APPROX.) ACCESS PANEL. PAINT TO MATCH ADJACENT EIFS LOCATION SHOWN IS APPROXIMATE.
- BRONZE BAFFLE MOVE PANEL TO KEEP BLOWN IN INSULATION OUT OF OPENING. PROVIDE MIN 3" RIGID INSULATION BOARD ABOVE ACCESS PANEL.
- PROVIDE SURFACE MOUNTED 2X BLOCKING FOR GARAGE TRACK. ATTACH TO EXISTING TRUSS. EXTEND BETWEEN EXISTING BULKHEAD. COORDINATE QUANTITY AND LOCATION AS REQUIRED BY OHD MANUFACTURER. APPROXIMATE LOCATION OF TUNNEL TO REMAIN.
- BACKER ROD OF SEALANT AT JOINT. PROVIDE BLOWN IN INSULATION R30.
- PROVIDE ROOFTOP INTAKE VENT AT ENTIRE PERIMETER. INSTALL AT ELEVATION ABOVE INSTALLED INSULATION. BOD GAF COBRA INTAKEPRO.
- PROVIDE POWERED ROOF VENT. REFERENCE MECHANICAL. INTAKE LOUVER REFERENCE MECHANICAL.
- EXHAUST FAN REFERENCE MECHANICAL. TRENCH DRAIN REFERENCE MECHANICAL.
- 31. REMOVAL AND REPLACEMENT OF SHINGLES IN BASE BID. ADD SELF ADHEREING UNDERLAYMENT UNDER ENTIRE SURFACE AS PART OF ALTERNATE.

  32. OVER MOTOR COORDINATE LOCATION AND SUPPORTS WITH MANUFACTURER.

  33. MOCK UP AREA FOR CUSTOM BRICK AND STONE.

6" DIA. STANDARD GALVANIZED
 STEEL PIPE BOLLARD FILLED W/
 CONCRETE - MOLD CONVEX
 CROWN AT TOP. PAINT. STEEL
 TRANSPORTED FOR THE PAINT. STEEL

EXPANSION JOINT MATERIAL &

16" DIA. CONCRETE ANCHOR

SEALANT

TROWEL FINISH.

14 W. Kemp Ave. Watertown, SD 57201

(605) 884-7090

Architecture

Engineering

www.teamtsp.com

CONSULTANTS

PROJECT TITLE

**CITY OF WATERTOWN RENOVATION AND ADDITION FOR NEW CITY HALL** WATERTOWN, SD


ISSUE DATE DESCRIPTION ISSUE DATE

CHECKED BY PROJECT# SHEET TITLE

FLOOR PLANS AND **ELEVATIONS -**

**ALTERNATE #1** 

SHEET NUMBER

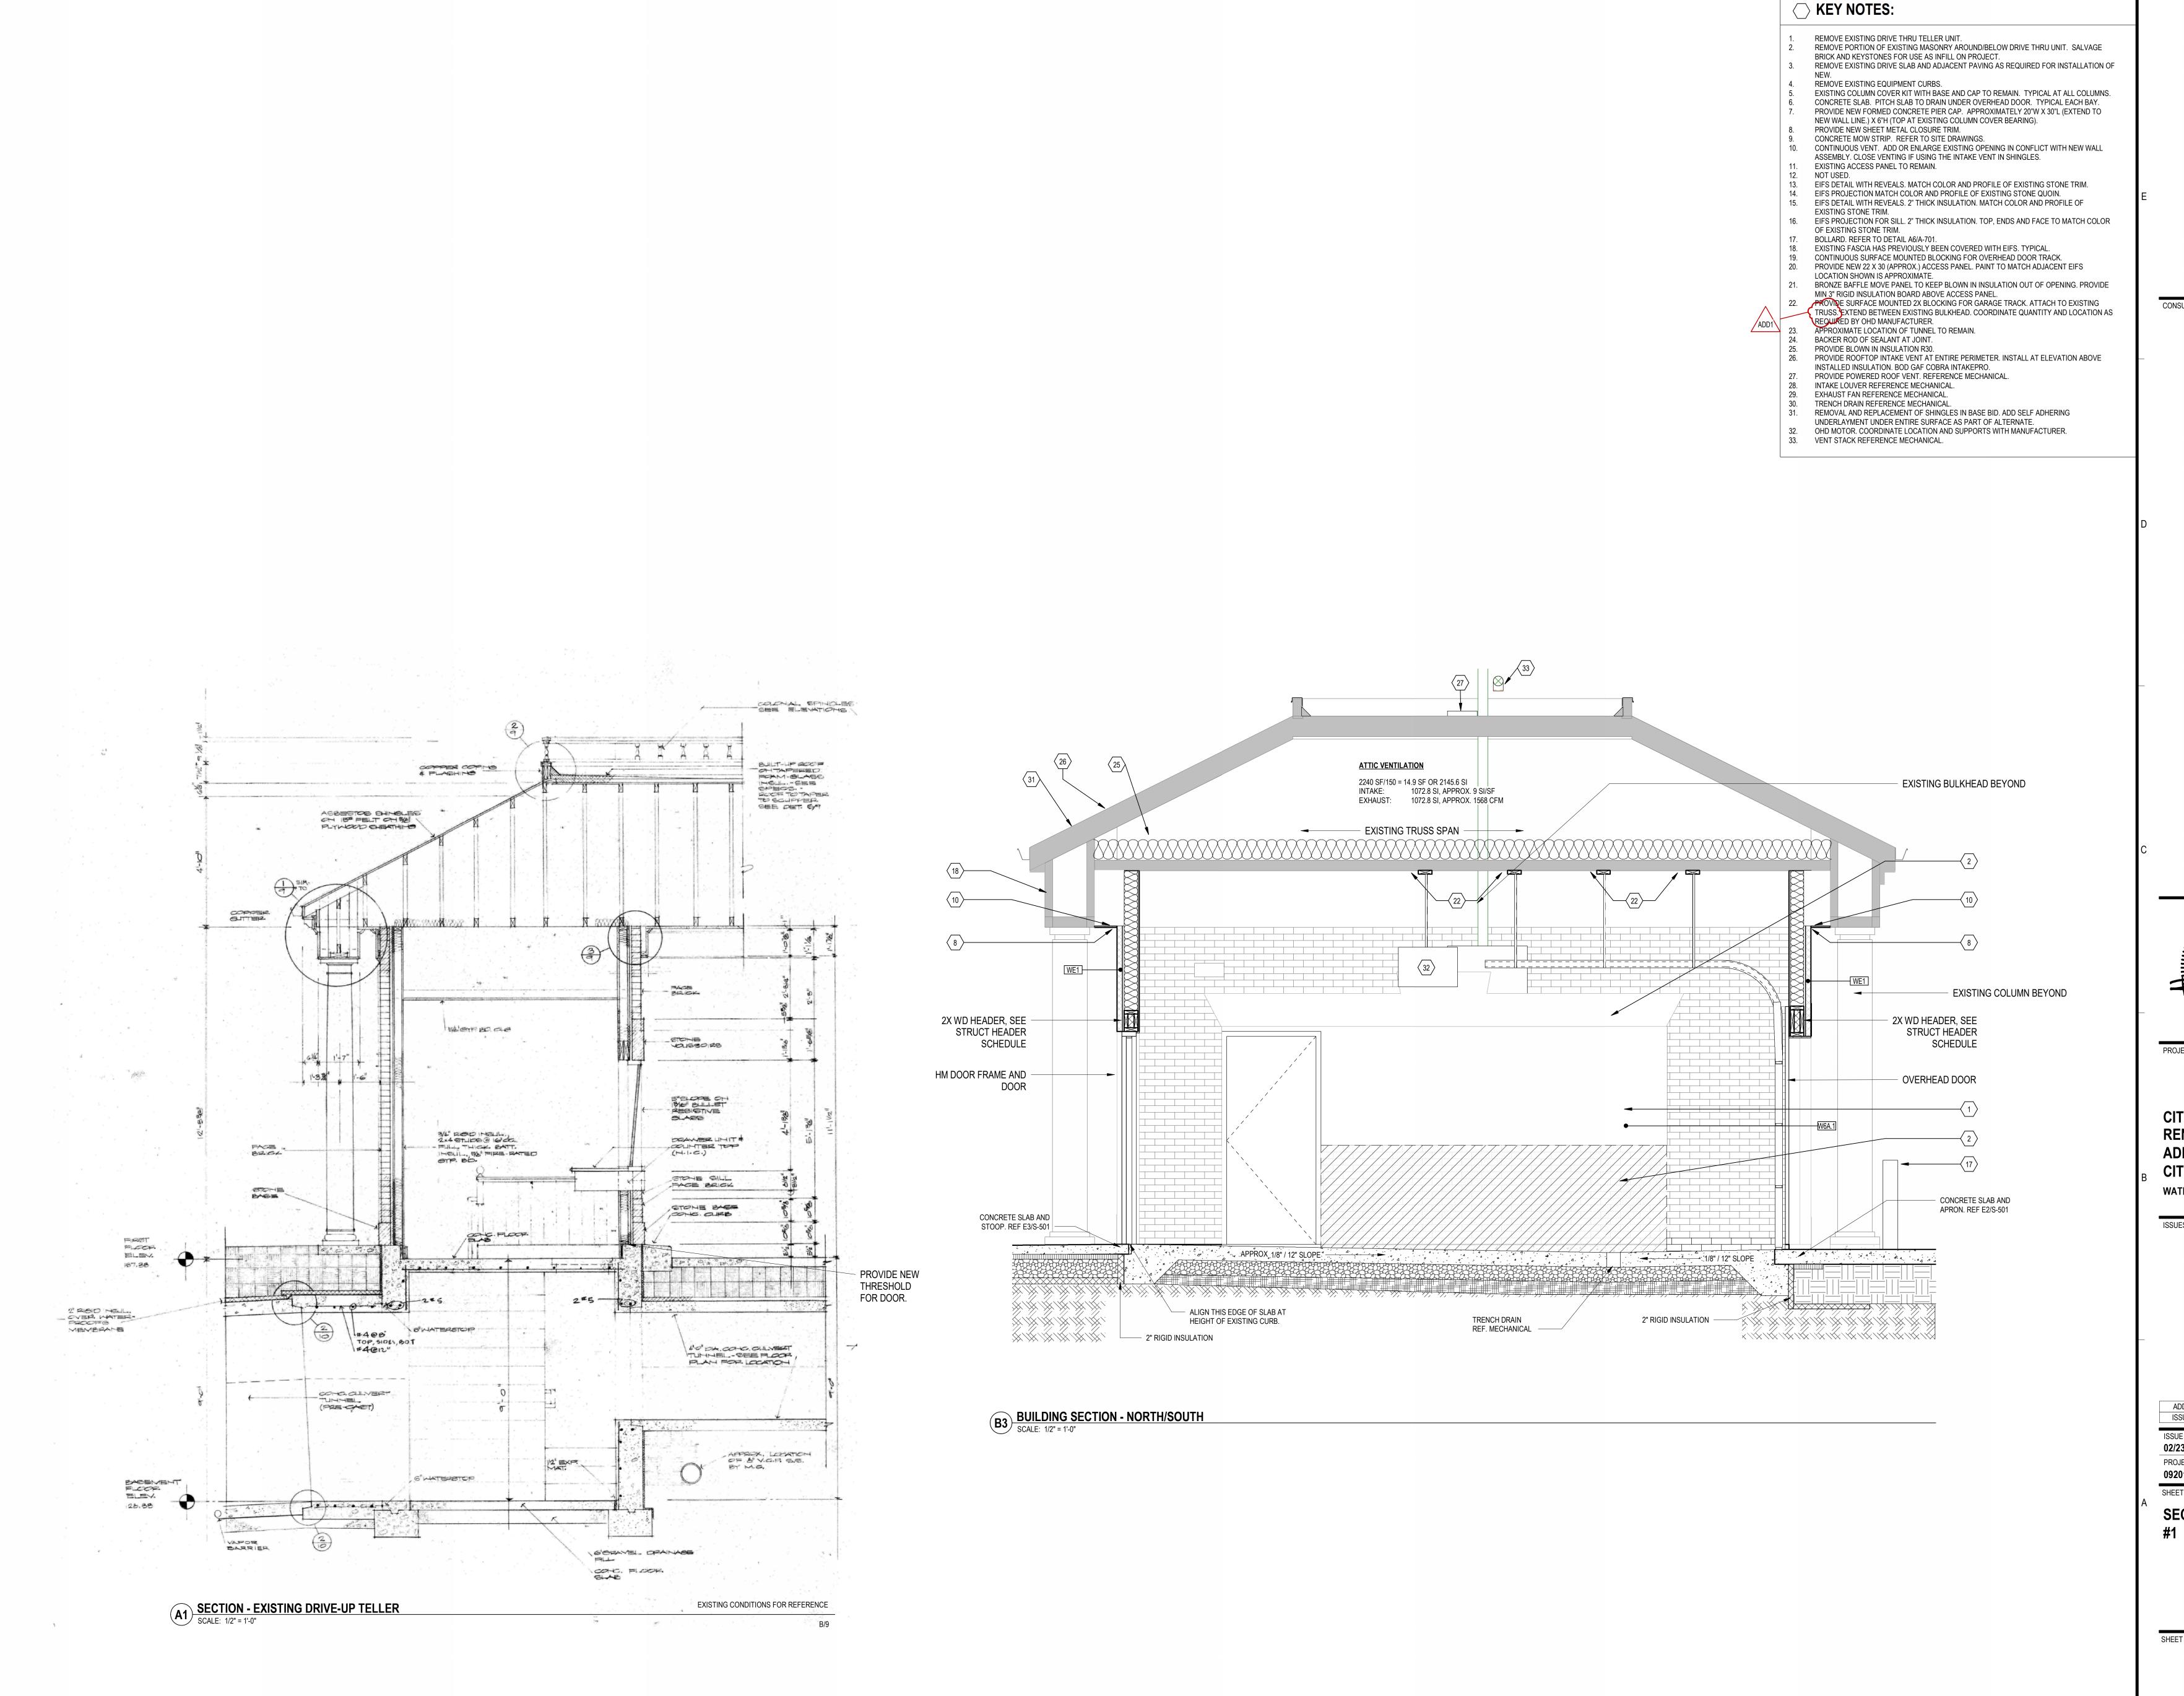


TSP

TSP, Inc. 14 W. Kemp Ave. Watertown, SD 57201

> (605) 884-7090 www.teamtsp.com

> > Architecture Engineering Planning

CONSULTANTS

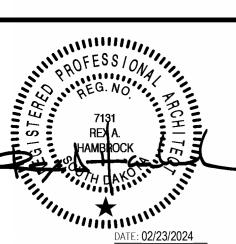

PROJECT TITLE

CITY OF WATERTOWN RENOVATION AND ADDITION FOR NEW CITY HALL WATERTOWN, SD

		DRAWN BY
ISSUE	DATE	DESCRIPTION
ADD1	03/05/2024	ADD1

 02/23/2024
 EMV

 PROJECT #
 CHECKED BY


 09201051
 RAH

HEET TITLE

SECTIONS - ALTERNAT

UMBER

**A-702** 

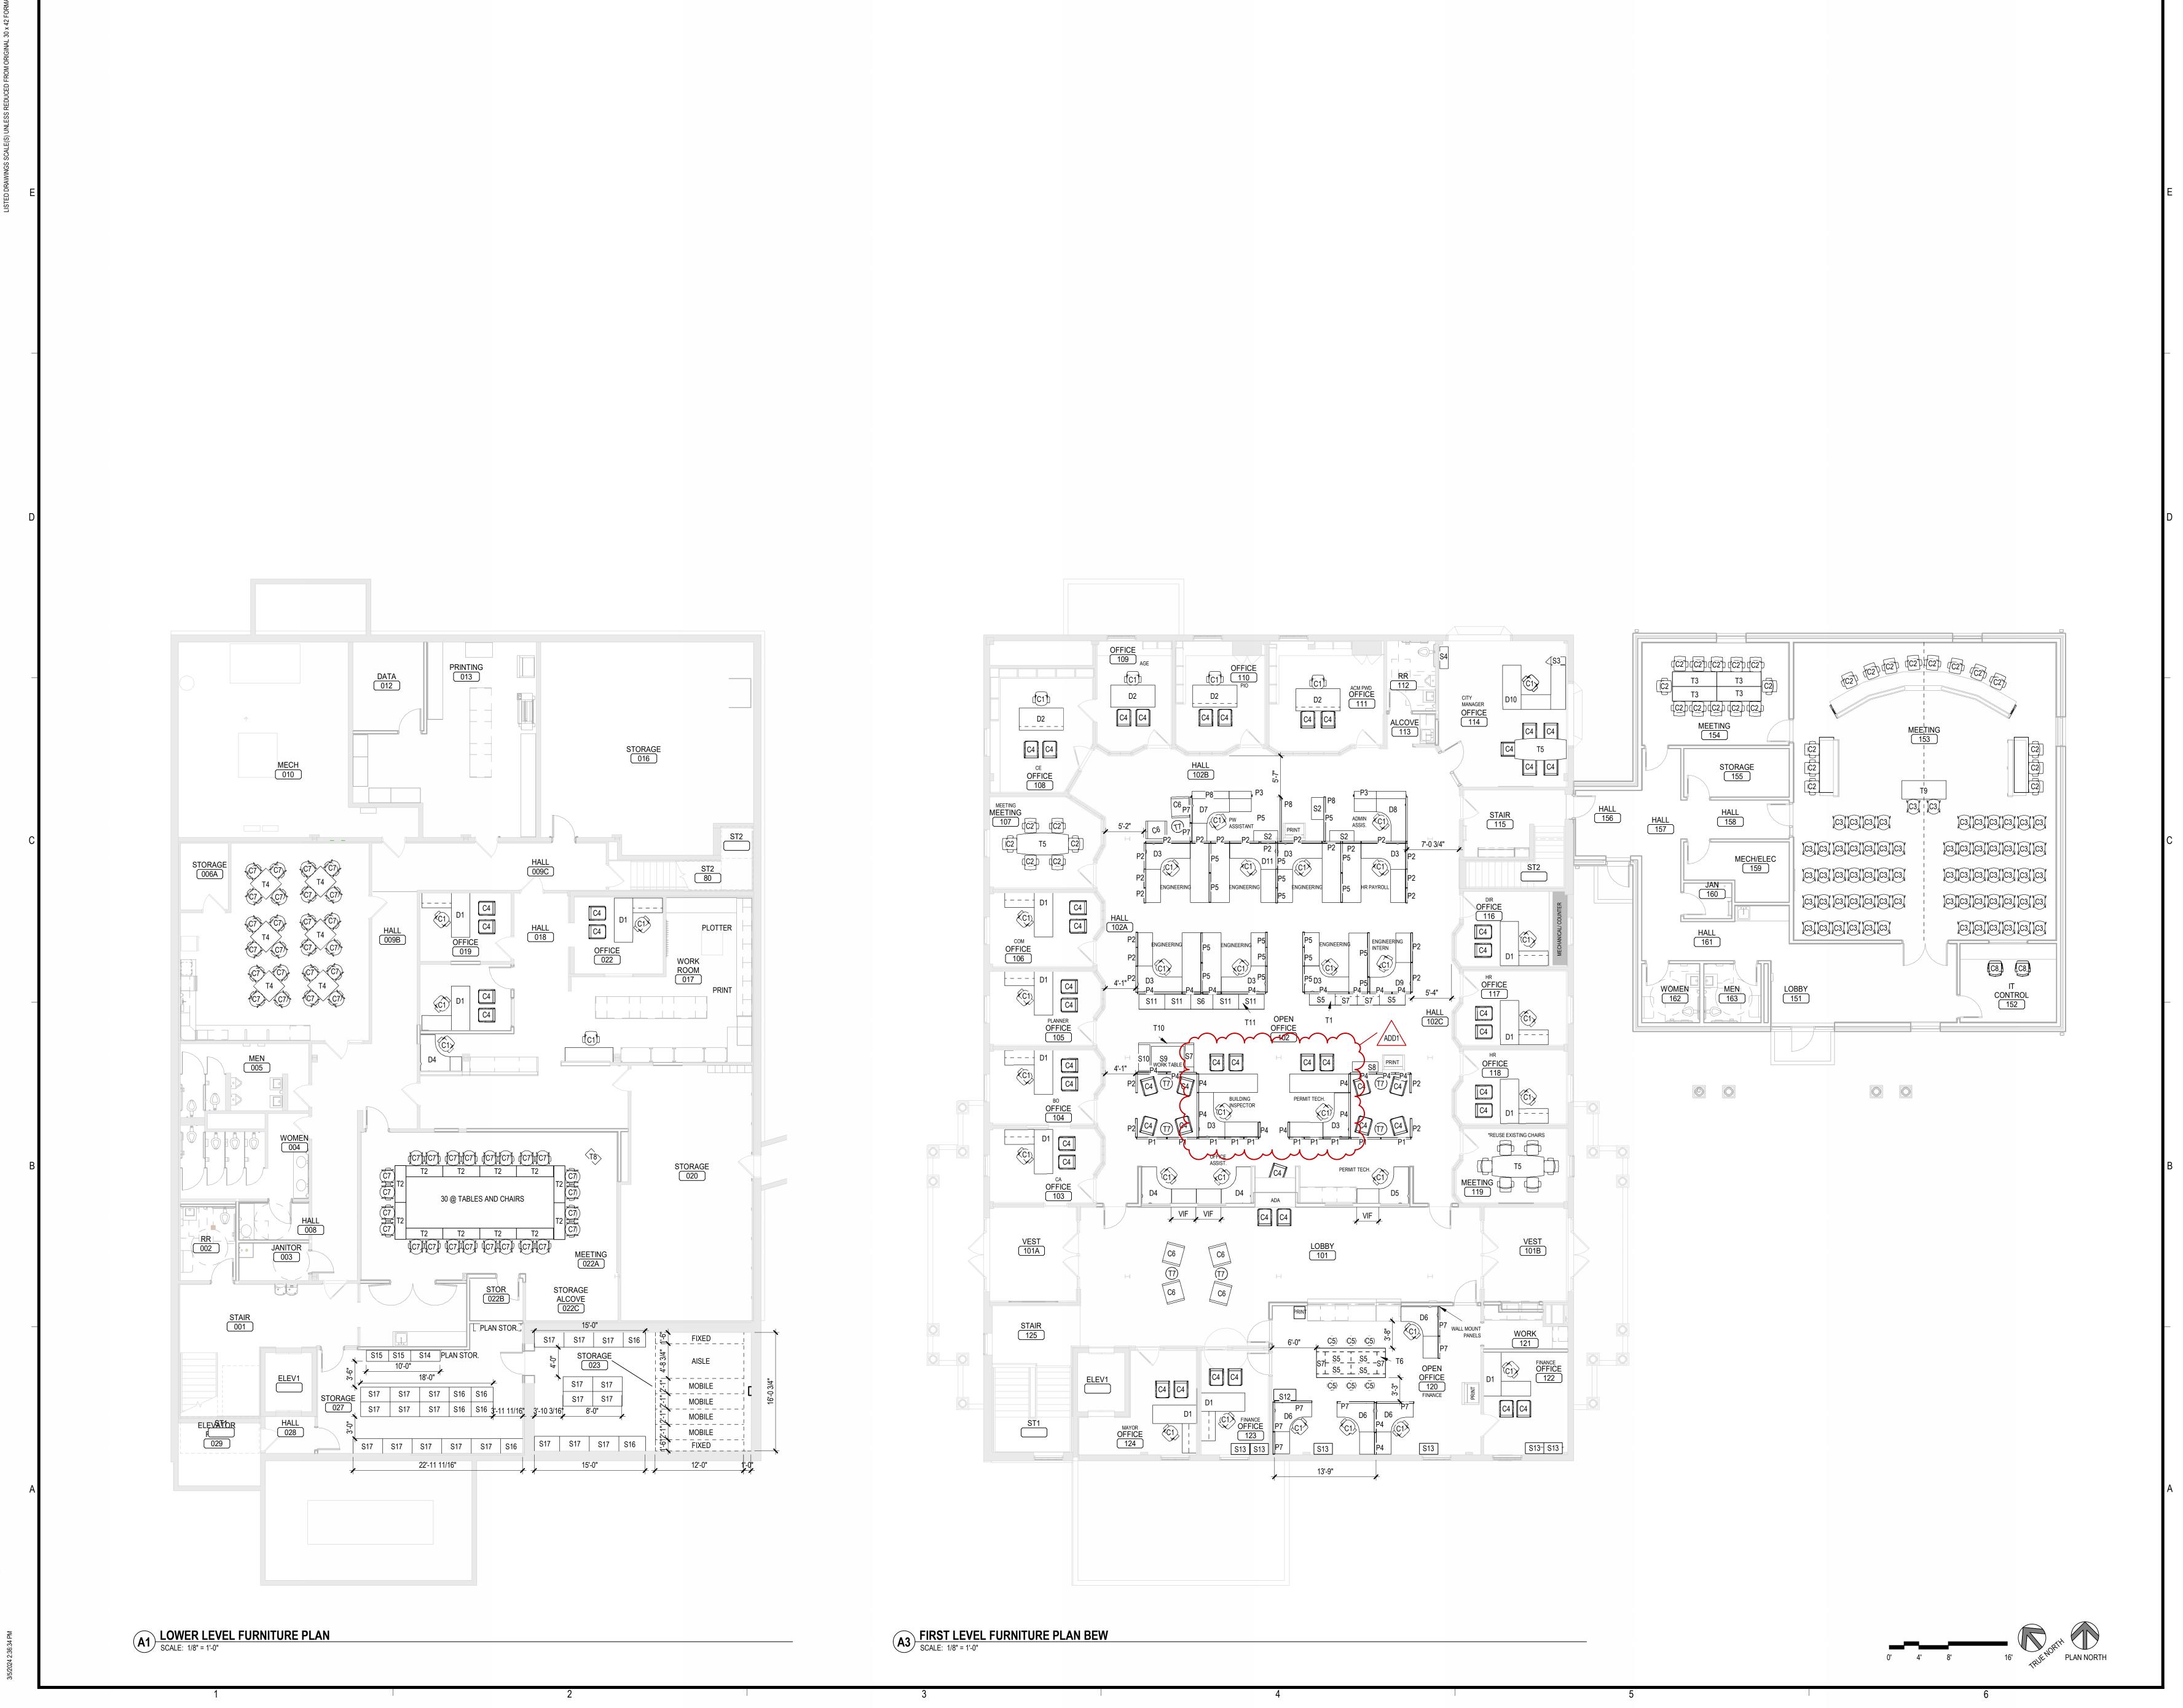

www.teamtsp.com


CONSULTANTS

**CITY OF WATERTOWN RENOVATION AND ADDITION FOR NEW CITY HALL** WATERTOWN, SD

ADD1 03/05/2024 ADD1
ISSUE DATE DESCRIPTION

CHECKED BY PROJECT#

INTERIOR FURNITURE **PLANS** 

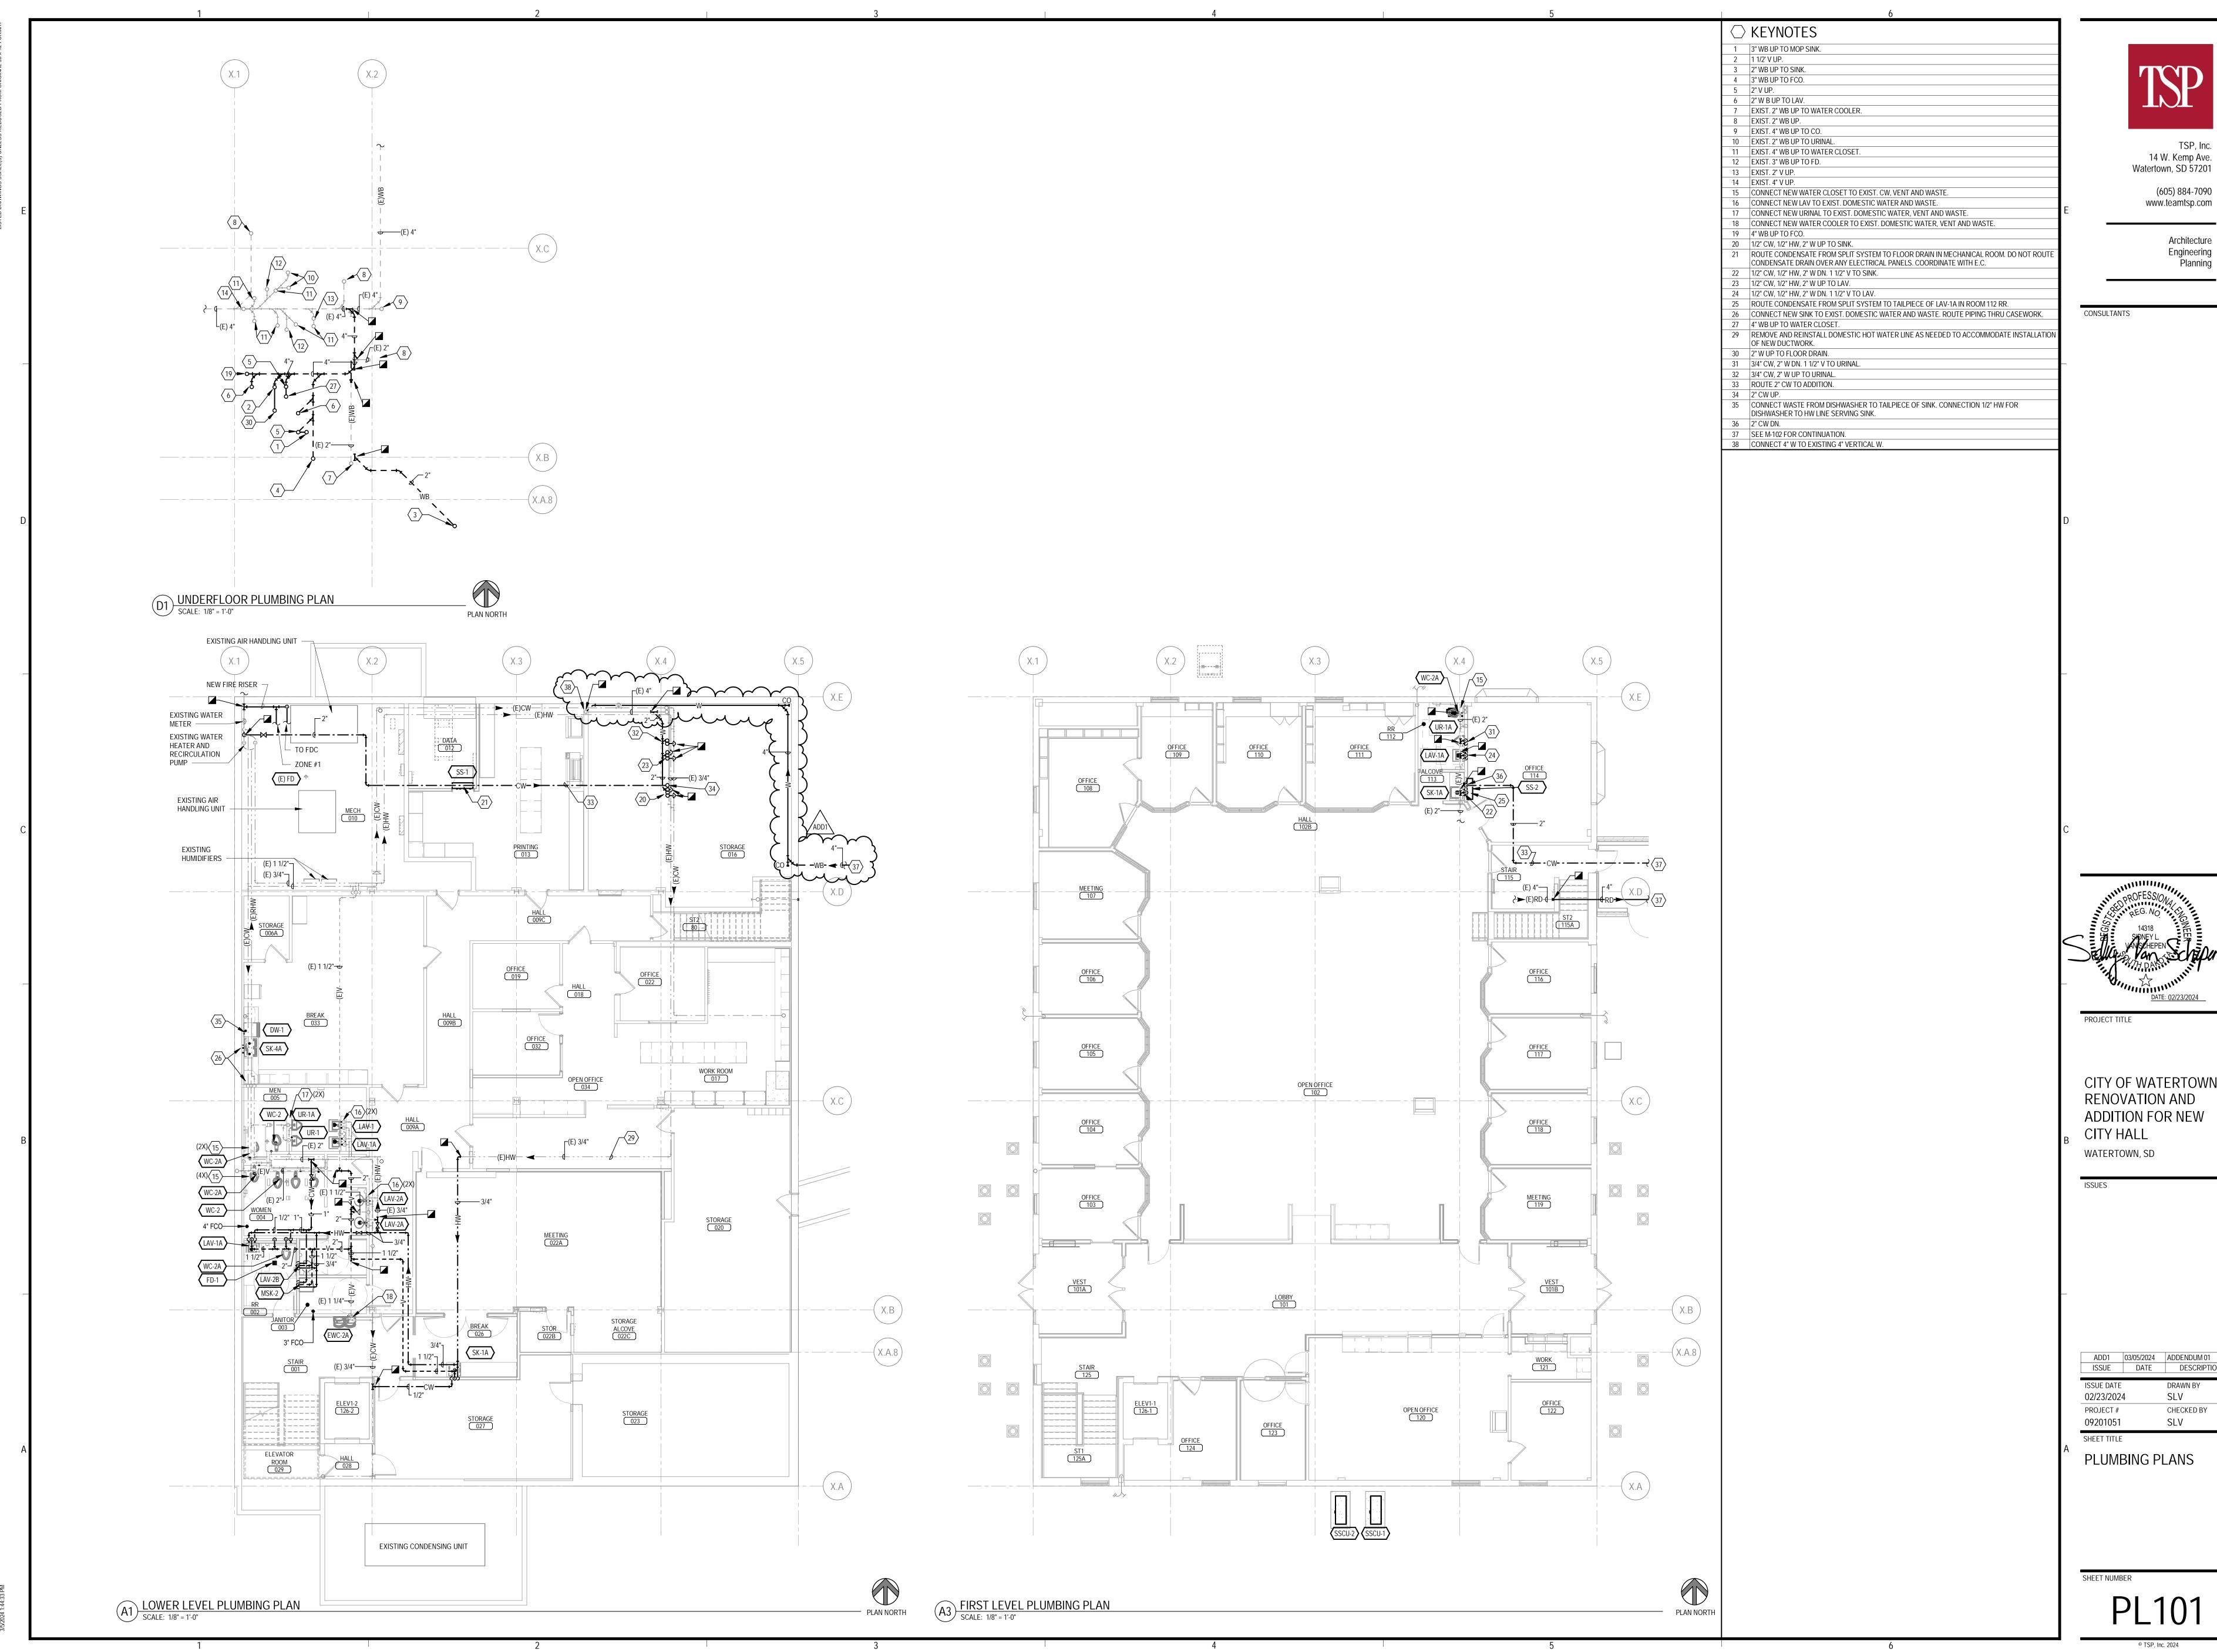



> Architecture Engineering


(605) 884-7090



CITY OF WATERTOWN RENOVATION AND ADDITION FOR NEW CITY HALL

ADD1	03/05/2024	ADDENDUM 01
SSUE	DATE	DESCRIPTION
JE DATE		DRAWN BY
23/202	4	SLV
NECT#		CHECKED BA

PLUMBING PLANS

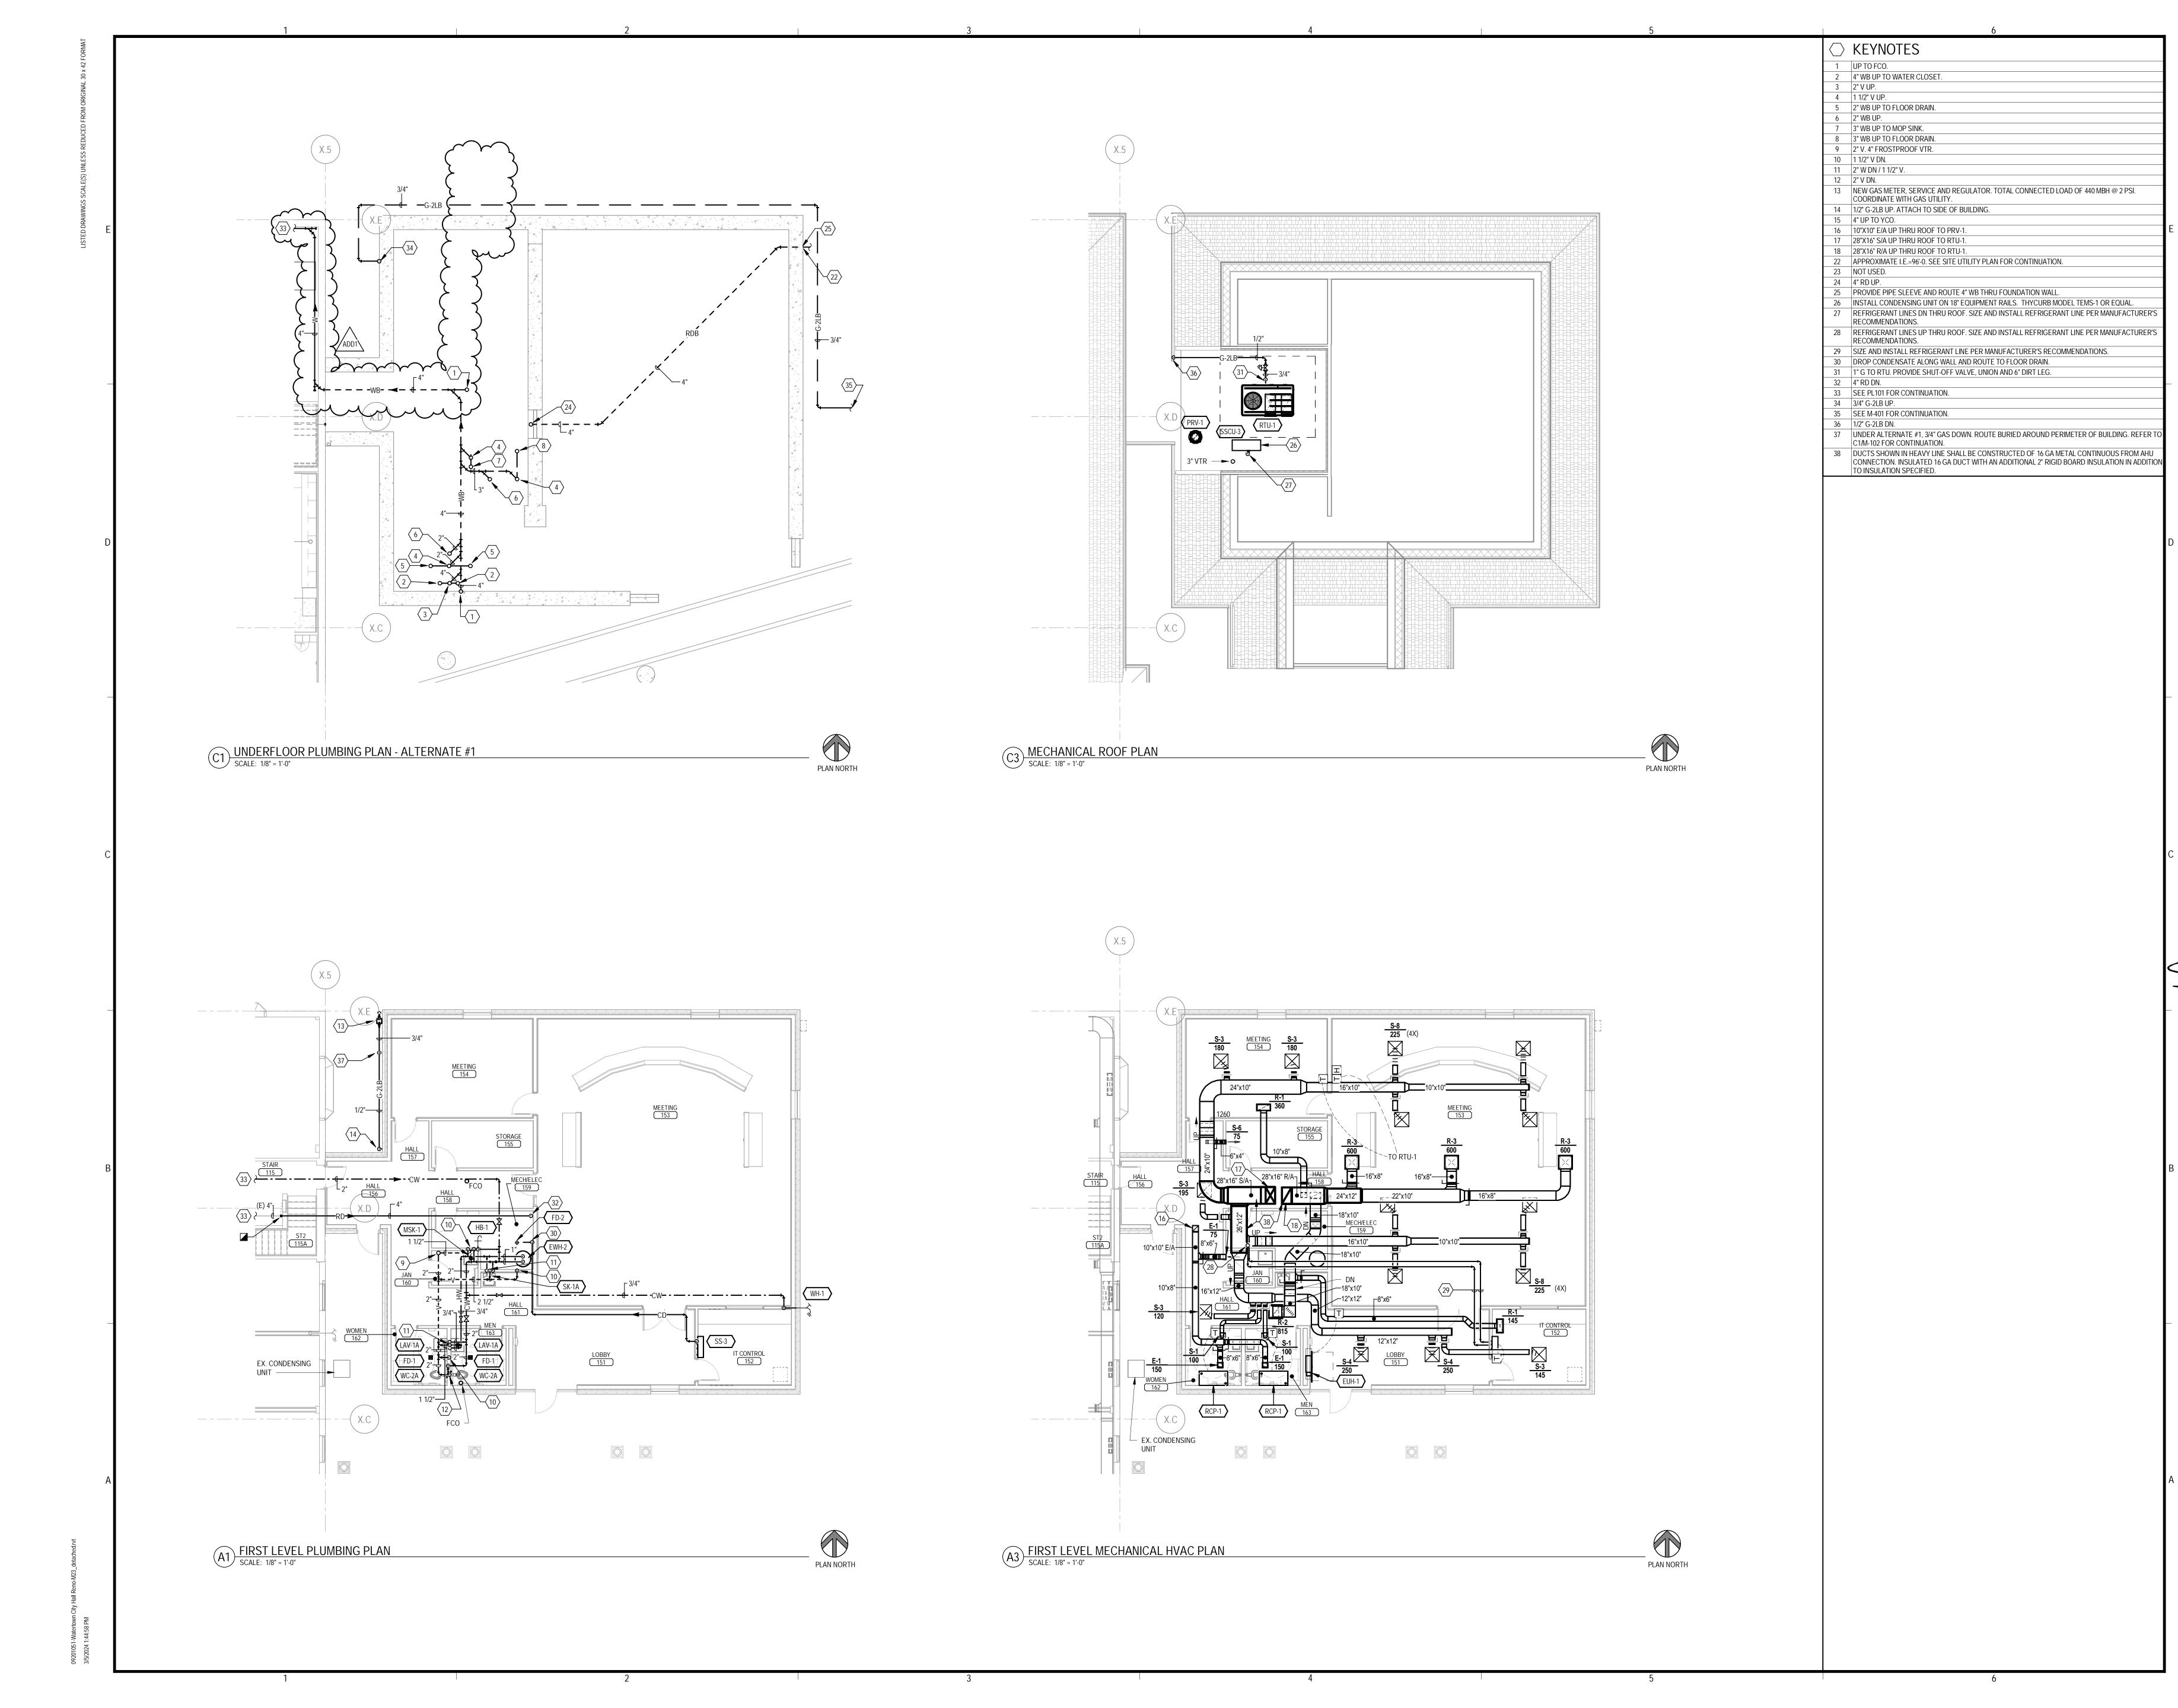

> (605) 884-7090 www.teamtsp.com

> > Engineering

Architecture

CONSULTANTS




PROJECT TITLE

CITY OF WATERTOWN RENOVATION AND ADDITION FOR NEW CITY HALL WATERTOWN, SD

ADD1 ISSUE	03/05/2024 DATF	ADDENDUM 01 DESCRIPTION	
ISSUE DATE		DRAWN BY	_
02/23/202	4	SLV	_ ,
PROJECT # <b>09201051</b>		CHECKED BY SLV	L
SHEET TITLE			<b>-</b>
•		L PLANS - ECHANICAL	

**PLANS** 

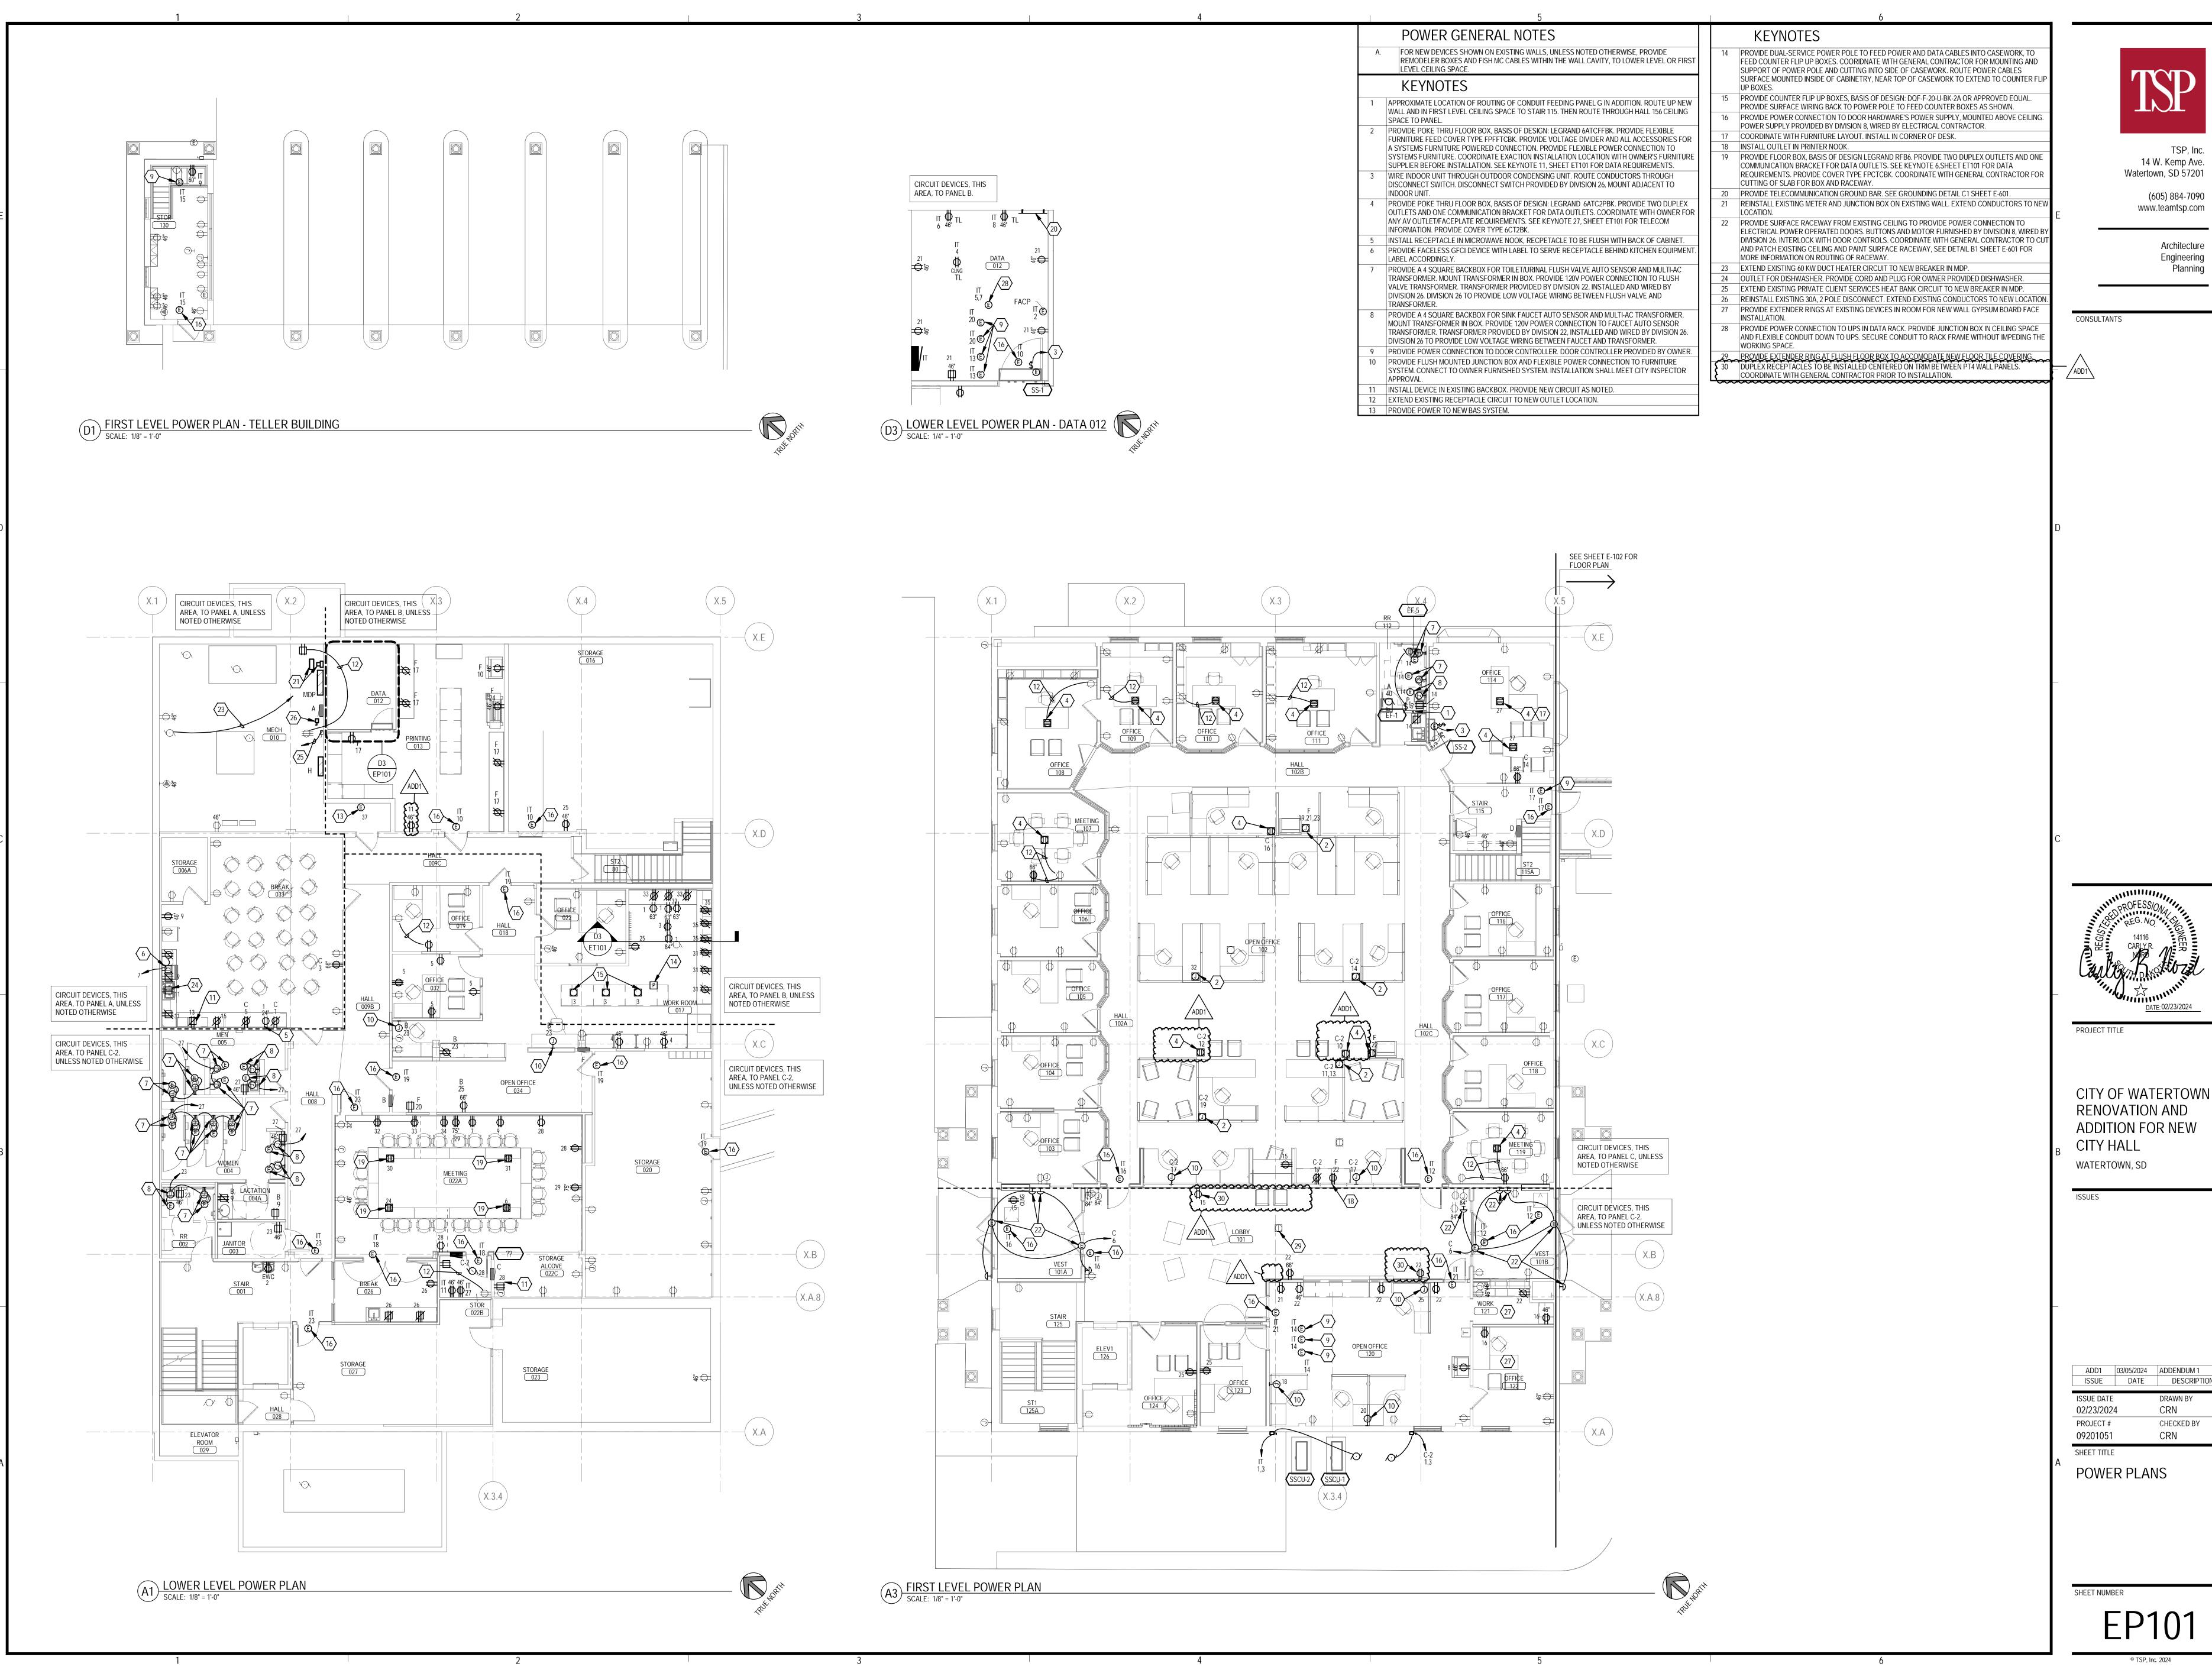

(605) 884-7090 www.teamtsp.com


Architecture

CONSULTANTS

ISSUE DATE DESCRIPTION

CRN CHECKED BY PROJECT #

POWER PLANS

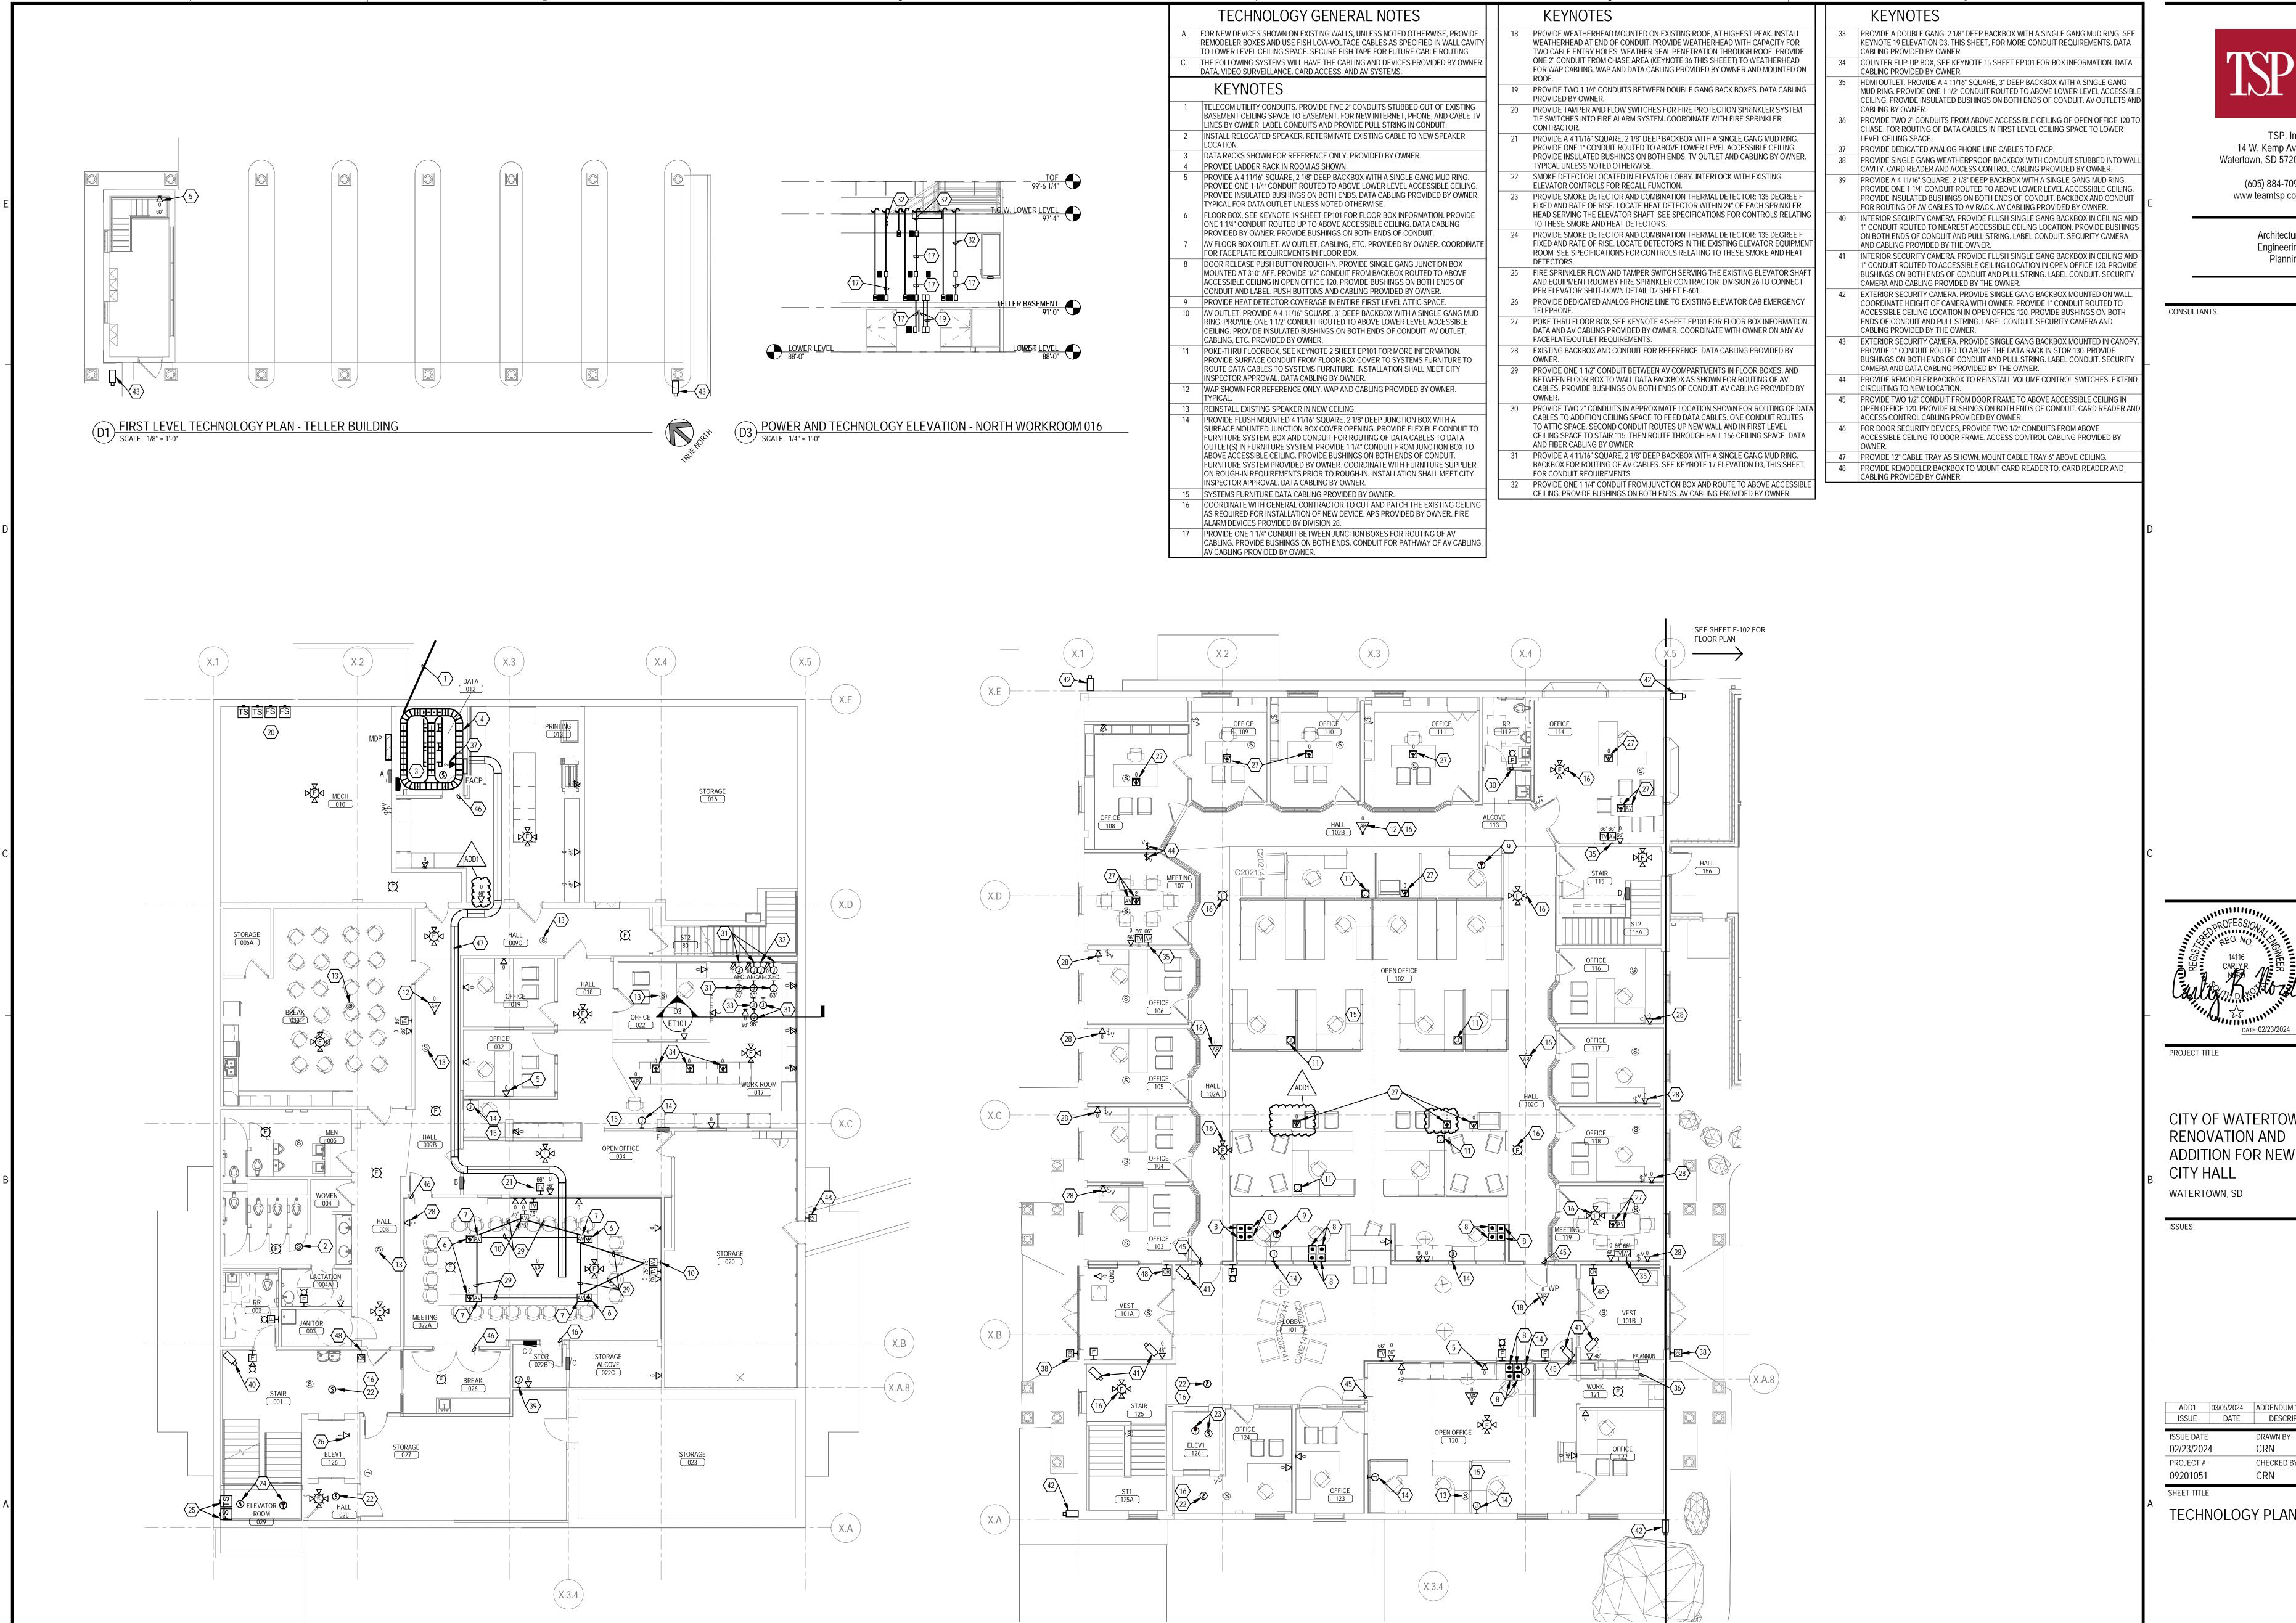

A3 FIRST LEVEL TECHNOLOGY PLAN

SCALE: 1/8" = 1'-0"

A1 LOWER LEVEL TECHNOLOGY PLAN

SCALE: 1/8" = 1'-0"

14 W. Kemp Ave. Watertown, SD 57201

> Architecture Engineering

(605) 884-7090

www.teamtsp.com

CITY OF WATERTOWN RENOVATION AND

TECHNOLOGY PLANS

LOCATION: STAIR 115 MOUNTING: RECESSE MAIN DEVICE: 225 A MLC BUS AMPS: 225 AMPS	D TYPE 1	I					VOLTA C. RATII SPECI	<b>NG</b> : 10				″. METRICAL	
LOAD DESCRIPTION	RATING	Р	СКТ	1	A	ı	В	,	С	СКТ	Р	RATING	LOAD DESCRIPTION
KIST. LTG OPEN OFFICE	20 A	1	1	0.0	0.0					2	1	20 A	EXIST. LTG OPEN OFFICE
KIST. LTG OPEN OFFICE	20 A	1	3			0.0	0.0			4	1	20 A	EXIST. LTG OPEN OFFICE
KIST. LTG OPEN OFFICE	20 A	1	5					0.0	0.0	6	1	20 A	EXIST. LTG OPEN OFFICE
(IST. LTG OPEN OFFICE	20 A	1	7	0.0	0.0					8	1	20 A	EXIST. LTG OPEN OFFICE
(IST. LTG OPEN OFFICE	20 A	1	9			0.0	0.0			10	1	20 A	EXIST. LTG OPEN OFFICE
KIST. LTG OPEN OFFICE	20 A	1	11					0.0	0.0	12	1	20 A	EXIST. LTG OPEN OFFICE
(IST. LTG EAST OFFICE	20 A	1	13	0.0	0.0					14	1	20 A	EXIST. HALL REC
(IST. LTG BOARD ROOM	20 A	1	15			0.0	0.0			16	1	20 A	EXIST. HALL REC
(IST. LTG HALLWAY	20 A	1	17					0.0	0.0	18	1	20 A	EXIST. BOARD ROOM REC
K. NGHT LGHTS OPEN OFF	20 A	1	19	0.0	0.0					20	1	20 A	EXIST. BOARD ROOM REC
K. NGHT LGHTS OPEN OFF	20 A	1	21			0.0	0.0			22	1	20 A	EXIST. BOARD ROOM REC
(IST. FLAG LIGHT	20 A	1	23					0.0	0.0	24	1	20 A	EXIST. EAST OFFICE REC
(IST. ATTIC LIGHT	20 A	1	25	0.0	0.0					26	1	20 A	EXIST. EAST OFFICE REC
(IST. ROOF HEAT TAPE	20 A	1	27			0.0	0.0			28	1	20 A	EXIST. EAST OFFICE REC
(IST. ROOF HEAT TAPE	20 A	1	29					0.0	0.0	30	1	20 A	EXIST. EAST OFFICE REC
(IST. REC INSTANT CASH	20 A	1	31	0.0	0.0					32	1	20 A	EXIST. ROOF HEAT TAPE
ALCT LIEAT INCTANT CACLL	20. 4	•	33			0.0				34	1		EXIST. SPACE
(IST. HEAT - INSTANT CASH	20 A	2	35					0.0	0.0	36	1	20 A	EXIST. ROOF HEAT TAPE
(IST. SPACE		1	37		0.0					38	1	20 A	EXIST. ROOF HEAT TAPE
(IST. SPACE		1	39							40	1		EXIST. SPACE
(IST. SPACE		1	41						0.0	42	1	20 A	EXIST. ENTRY SIGNS
	TOTA			0 k	VA	0 k	VΑ	0 1	VΑ				
	TOTA			_	Α	L	Α		Α				
DAD CLASSIFICATION	CONN	ECT	ED		DEMAN	ID	ES	TIMATI	<b>E</b> D				PANEL TOTALS
												CON	NECTED LOAD: 0 VA
													ATED DEMAND: 0 VA
												CONNEC	TED CURRENT: 0 A
											E	CONNEC	

	LOCATION: MECH/E MOUNTING: SURFAC MAIN DEVICE: 225 A MI BUS AMPS: 225 AMF	CE TYPE 1 LO						C. RATI	AL: BA	,000 AN	MPS SY DO N	/MN IOT	IETRICAL PROVIDE	PANEL. NEL AS SCHEDI	JLED	_
N	LOAD DESCRIPTION	RATING	P	СКТ		A		В		C	СКТ	Р	RATING	LOAD DES	CRIPTION	
	LTG - MEETING 153	20 A	1	1	1.3	0.7					2	1	20 A	LTG - 151-2, 154	1-63	T
	LTG - 153-155	20 A	1	3			1.0	0.5			4	1	20 A	REC - 159 - 161		7
	PRV-1, REC - 156-157, EXT	20 A	1	5					1.1	6.4	6					
	REC MEETING 154	20 A	1	7	1.1	6.4					8	3	70 A	RTU-1		
	REC ROOM 154, 155, 158	20 A	1	9			1.1	6.4			10					
	REC	20 A	1	11					0.4	1.2	12	1	20 A	REC LOBBY 151		
	RCP-1; REC - 162-3	20 A	1	13	0.6	0.7					14	1	20 A	REC IT CONTRO	DL 152	
	IT CONTROL 152	20 A	1	15			0.9	0.5			16	1	20 A	REC 153 CHAM	BER TABLE	
	REC 153 CHAMBER TABLE	20 A	1	17					0.5	0.9	18	1	20 A	REC MEETING	153	
	REC 153 W STAFF TABLE	20 A	1	19	0.5	0.9					20	1	20 A	REC MEETING	153	
	REC 153 PRESENT TABLE	20 A	1	21			0.4	0.7			22	1	20 A	REC MEETING	153	_
	REC MEETING 153	20 A	1	23					0.4	1.0	24	1	15 A	RCP-1		
				25	2.6	2.0					26					
	EUH-1	25 A	3	27			2.6	2.0			28	3	25 A	WH-1		
				29					2.6	2.0	30					
	SSCU-3, SS-3	25 A	2	31	1.1	0.5					32	1	20 A	REC - CANOPY		
	3300-3, 33-3	25 A	_	33			1.1	0.5			34	1	20 A	REC - CANOPY		
	SPARE	20 A	1	35					0.0	0.5	36	1	20 A	REC 153 E STA	FF TABLE	
	SPARE	20 A	1	37	0.0						38	1		SPACE		
	SPARE	20 A	1	39			0.0				40	1		SPACE		
	SPARE	20 A	1	41					0.0		42	1		SPACE		
	SPARE	20 A	1	43	0.0						44	1		SPACE		
	SPARE	20 A	1	45			0.0				46	1		SPACE		
	SPARE	20 A	1	47					0.0		48	1		SPACE		
	SPARE	20 A	1	49	0.0						50	1		SPACE		
	SPARE	20 A	1	51			0.0				52	1		SPACE		
	SPARE	20 A	1	53					0.0		54	1		SPACE		
				OAD:		kVA		kVA		kVA	-					
ΙΟΔΙ	D CLASSIFICATION	CONN				3 A <b>DEMAN</b>	L	8 A <b>F</b> S	TIMATE	8 A =D				PANEL TOTALS	3	_
REC		1332				87.54%			1660 V					TANLE TOTAL		_
LTG		264	2 V	4		125.00	%	3	303 VA				CON	NECTED LOAD:	52400 VA	_
SPEC	0	718	4 V	4		102.43	%	7	'358 VA				ESTIMA	ATED DEMAND:	56352 VA	
Lighti	-		) VA			125.00			400 VA					TED CURRENT:		
MTR		2939	92 V	A		116.24	%	3	4165 V	4		E	ST. DEM	AND CURRENT:	156 A	_
NOTI																_

			E>	(IST	ING	PAN	ELB	OAR	D: A						
	LOCATION: MECH 01 MOUNTING: SURFAC MAIN DEVICE: 225 A ML BUS AMPS: 225 AMP	E TYPE 1 .O						_					′. METRICAL		
N	LOAD DESCRIPTION	RATING	Р	СКТ		A		В			СКТ	Р	RATING	LOAD DESCRIPTION	N
1	REC BREAK 006 MICRO	20 A	1	1	0.2	0.0					2	1	20 A	EXIST. LTG 1ST LVL OFFICES	;
	EXIST. REC - BREAK	20 A	1	3			0.0	0.0			4	1	20 A	EXIST. LTG 1ST LVL OFFICES	;
	EXIST. REC - BREAK	20 A	1	5					0.0	0.0	6	1	20 A	EXIST. LTG 1ST LVL OFFICES	;
1	REC BREAK 006 MICRO	20 A	1	7	0.2	0.0					8	1	20 A	EXIST. REC 1ST LVL OFFICES	3
1	REC BRK 006 FRIDGE, CNTR	20 A	1	9			0.4	0.0			10	1	20 A	EXIST. KITCHEN UNIT	+
1	REC BREAK 006 COUNTER	20 A	1	11					0.4	0.0	12	1	20 A	EXIST. REC 1ST LVL OFFICES	3
1	REC BREAK 006 COUNTER	20 A	1	13	0.2	0.0					14	1	20 A	EXIST. LOAD	
1	REC BREAK 006 COUNTER	20 A	1	15			0.2	0.0			16	1	20 A	EXIST. REC 1ST LVL OFFICES	3
	EXIST. CIRC PUMP	20 A	1	17					0.0	0.0	18	1	20 A	EXIST. REC 1ST LVL OFFICES	3
	EXIST. REC - W MECH ROOM	20 A	1	19	0.0	0.0					20	1	20 A	EXIST. REC 1ST LVL OFFICES	3
	EXIST. EXT LTG CONTROLS	20 A	1	21			0.0	0.0			22	1	20 A	EXIST. REC 1ST LVL OFFICES	3
				23					0.0	0.0	24	1	20 A	EXIST. REC 1ST LVL OFFICES	3
	EXIST. HOT WATER HEATER	30 A	2	25	0.0	0.0					26	1	20 A	EXIST. SIGN LIGHT	
	EXIST. LTG - MECH ROOM	20 A	1	27			0.0				28	1		EXIST. SPACE	
	EXIST. REC - MECH ROOM	20 A	1	29					0.0		30	1		EXIST. SPACE	
				31	0.0						32	1		EXIST. SPACE	
	EXISTING KITCHEN UNIT	30 A	2	33			0.0	0.0			34	1	20 A	EXISTING LOAD	
	EXIST. MECH OUTLET	20 A	1	35					0.0	0.0	36	1	20 A	EXIST. INSTANT CASH SIGN	
	EXIST. INSTANT CASH LTG	20 A	1	37	0.0	0.8					38	1	20 A	SITE LIGHTING S	1
	EXIST. OUTSIDE TERM.	20 A	1	39			0.0	1.1			40	1	20 A	EF-1	1
	EXISTING LOAD	20 A	1	41					0.0	0.0	42	1	20 A	EXISTING LOAD	
		тот	AL L	OAD:	1 k	XVA	21	ΚVA	0 k	VA		_			
		TOTA	AL A	MPS:	12	2 A	15	5 A	3	Α					
LOA	D CLASSIFICATION	CONN	ECT	ED		DEMAN	1D	ES	TIMATE	D				PANEL TOTALS	
REC	;	144	0 V	4		100.00	%	1	1440 VA						
LTG		808				125.00			1007 VA					NECTED LOAD: 3356 VA	
MTR		112	7 V	4		125.00	%	1	1409 VA					ATED DEMAND: 3836 VA	
													CONNEC	TED CURRENT: 9 A	
												E	EST. DEM	AND CURRENT: 11 A	

			EX	(IST	ING	PAN	ELB	OAR	D: E							
	LOCATION: HALL 031 MOUNTING: SURFACI MAIN DEVICE: 100 A MC BUS AMPS: 100 AMPS	E TYPE 1 B							NG: 10 AL: M	,000 AM	MPS S	YMN S/A	//ETRICAL	TO PANEL ONL	Y TO BE	
N	LOAD DESCRIPTION	RATING	Р	СКТ		A		В		C	скт	Р	RATING	LOAD DES	SCRIPTION	N
	SPARE (DRIVE THRU EQUIP)		1	1	0.0	0.0					2	1	30 A	SPARE (DRIVE		
1	SPARE (GRG DR RECEPT)	20 A	1	3			0.0	0.0			4	1	30 A	SPARE (DRIVE	THRU EQUIP)	
	EXISTING - CANOPY LTG	20 A	1	5					0.0	0.0	6	1	20 A	SPARE (GRG D	R RECEPT)	1
	EXISTING LOAD - HEAT-AC			7	0.0	0.0					8					
	UNIT	30 A	2	9			0.0	0.0			10	2	30 A	SPARE (PREV.	ATM MACHINE)	
	EXISTING - E ISO GND REC	20 A	1	11					0.0	0.0	12	1	20 A	EXISTING LOAI	D - CANOPY	
	EXISTING - BASEMENT LTG	20 A	1	13	0.0	0.0					14	1	20 A	EXISTING -1ST	LANE LTG	
	EXISTING - BASEMENT REC	20 A	1	15			0.0	0.8			16	1	15 A	EF-2, EF-3, EF-	4	1
	EXISTING - UPSTAIRS LTG	20 A	1	17					0.0	0.0	18	1	20 A	SPARE (GRG D	R RECEPT)	1
1	GDCP-1	20 A	1	19	0.0	0.0					20	1	15 A	EXISTING LOAI	D - REC W	
	EXISTING LOAD	20 A	1	21			0.0	0.0			22	1	20 A	EXISTING LOAI	)	
	EXISTING LOAD - HEATER &			23					0.0	0.0	24	1	20 A	EXISTING LOAI	D - REC TELLER	
	NEW AC UNIT	20 A	2	25	0.0	0.0					26	1	20 A	EXISTING LOAI	)	
	EXISTING - CANOPY LTG	20 A	1	27			0.0	1.1			28	1	15 A	UH-1, UH-2		1
	EXISTING - CANOPY LTG	20 A	1	29					0.0	0.0	30					
	EXISTING - EXHAUST FAN	15 A	1	31	0.0	0.0					32	3	60 A	EXISTING LOAI	D - TUNNEL	
	EXISTING LOAD - OUTSIDE			33			0.0	0.0			34			TIL/TILIT		
	AC CONDENSER	30 A	2	35					0.0	0.0	36	1	20 A	SPARE (GRG D	R RECEPT)	1
	EXISTING - EXT. POLE LTG	20 A	1	37	0.0	0.0					38	1	20 A	SPARE (GRG D	R RECEPT)	1
	SPARE (SPECIAL OUTLET -	22.4		39			0.0	0.0			40	1	20 A	SPARE (GRG D	R RECEPT)	1
	BEHIND MECH HEATER?)	60 A	2	41					0.0		42	1		SPACE		
		тот	AL L	OAD:	0	kVA	2 k	VΑ	0 k	VA						
				MPS:		) A		6 A		Α					_	
LOA SPE	D CLASSIFICATION	CONN	6 V			100.00°			TIMATI 1056 VA					PANEL TOTAL	<b>S</b> ⊺	
MTR			O VA			112.86			948 VA				CON	NECTED LOAD:	1896 VA	
				-			,,,							ATED DEMAND:		
													CONNEC	TED CURRENT:	5 A	
													EST. DEM	AND CURRENT:	6 A	

USE EXISTING BREAKER MADE AVAILABLE BY DEMOLITION TO FEED NEW LOADS AS NOTED.

			E>	(IST	ING	PAN	ELB	OAR	D: C						
	LOCATION: STORAG MOUNTING: RECESS MAIN DEVICE: 225 A ML BUS AMPS: 225 AMP	ED TYPE <sup>.</sup> O		2C				VOLTA C. RATII SPECI	<b>NG</b> : 10				T. METRICAL		
N	LOAD DESCRIPTION	RATING	P	СКТ		A	ı	В		3	СКТ	P	RATING	LOAD DES	CRIPTION
1	REC BREAK 006 CNTR	20 A	1	1	0.2	0.4					2	1	20 A	LTG - 1ST LEVE	L SOFFIT 102
1	REC - 006-008	20 A	1	3			0.4	0.0			4	1	20 A	EXIST. LTG EN	ΓRY
1	REC BREAK 006, CNTR	20 A	1	5					0.2	0.5	6	1	20 A	POWERED DO	DRS
	EXIST. SPACE		1	7							8	1		EXIST. SPACE	
	EXIST. REC - SAFE DEPOSIT	20 A	1	9			0.0	0.0			10	1	20 A	EXIST. LTG ELE	٧
	EXIST. REC - STAFF WRK	20 A	1	11					0.0	0.0	12	1	20 A	EXIST. REC - E	NTRY
	EXIST. REC MACHINE	20 A	1	13	0.0	0.7					14	1	20 A	REC - 112-114	
	EXIST. REC MACHINE	20 A	1	15			0.0	0.2			16	1	20 A	1ST LEVEL CO	PIER FLR BOX
	EXIST. REC MACHINE	20 A	1	17					0.0	0.8	18	1	20 A	LTG - 011-017	
	EXIST. REC MACHINE	20 A	1	19	0.0	1.1					20	1	20 A	LTG - 002-9, 01	3-9, 021,021A
	EXIST. VAULT SECURITY	20 A	1	21			0.0	1.0			22	1	20 A	LTG - 023, 027-	)28
	EXIST. ELEV RM HEATER	20 A	1	23					0.0	0.0	24	1	20 A	EXIST. MONITO	R CAB
	EXIST. VAULT HEATER	20 A	1	25	0.0	0.0					26	1	20 A	EXIST. LOAD	
1	REC MEETING 114 FLRBXS	20 A	1	27			0.7	0.0			28	1	20 A	EXIST. LOAD	
	EXIST. LOAD	20 A	1	29					0.0	0.0	30	1	20 A	EXIST. LOAD	
1	LTG - 020, 022A-C	20 A	1	31	0.8	0.5					32	1	20 A	1ST LEVEL SYS	FURN
	EXIST. FED LINK	20 A	1	33			0.0				34	1		SPACE	
	EXIST. COMPUTER CRT	20 A	1	35					0.0	0.0	36			22.25	
	EXIST. SPARE	20 A	1	37	0.0	0.0					38	2	20 A	SPARE	
	EXIST. SPACE		1	39							40	1		EXIST. SPACE	
	EXIST. SPACE		1	41							42	1		EXIST. SPACE	
		тот		OAD:	41	κVA	2 k	VA.	1 k	VA			I		
	- 01 4001 <del>-</del> 10 4 <del>-</del> 10 1			MPS:		1 A		) A		2 A					
LOA Othe	D CLASSIFICATION	CONN	ECT VA	ED		<b>DEMAN</b> 0.00%		ES	TIMATE 0 VA	<u>:</u> D				PANEL TOTAL	S 
REC		282		4		100.009		2	2820 VA				CON	NECTED LOAD:	7292 VA
LTG		403	9 V	٩		125.00	%	5	049 VA				ESTIM	ATED DEMAND:	8307 VA
SPE	C	480	) VA	١		100.00	%		480 VA				CONNEC	TED CURRENT:	20 A
Light	ing	64	VA			125.00	%		80 VA			E	ST. DEM	AND CURRENT:	23 A


	LOCATION: OPEN OF MOUNTING: RECESSI	FICE 034		(IST	ING	PAN	,		GE: 20	8Y/120			IETRICAL			
	MAIN DEVICE: 225 A ML BUS AMPS: 225 AMPS							SPECI	AL:		ı					
N	LOAD DESCRIPTION	RATING	Р	СКТ		A		В	(		СКТ	Р	RATING	LOAD DES	CRIPTION	
1	REC WORK ROOM 016	20 A	1	1	0.7	0.0					2	1	20 A	EXISTING REC		T
1	REC 016, CNTR BOXES	20 A	1	3			0.9	0.0			4	1	20 A	EXISTING REC		T
	EXISTING REC	20 A	1	5					0.0	0.0	6	1	20 A	EXISTING REC		T
	EXISTING REC	20 A	1	7	0.0	0.0					8	1	20 A	EXISTING REC		T
1	REC LACTATION 004A	20 A	1	9			0.4	0.0			10	1	20 A	EXISTING LOAD	)	
1	REC PRINTING 013 COPIER	20 A	1	11					0.2	0.0	12	1	20 A	EXISTING LOAD	)	T
	EXISTING LOAD	20 A	1	13	0.0	0.0					14	1	20 A	EXISTING LOAD	)	$\top$
	EXIST REC	20 A	1	15			0.0				16	1		EXIST. SPACE		$\top$
	SPARE (FROM DEMOLITION)	20 A	1	17					0.0		18	1		EXIST. SPACE		$\top$
	EXISTING REC	20 A	1	19	0.0						20	1		EXIST. SPACE		T
1	REC ROOM 015, 016	20 A	1	21			0.9				22	1		EXIST. SPACE		T
1	REC OPEN OFFICE 011	20 A	1	23					0.9		24	1		EXIST. SPACE		$\top$
1	REC ROOM 011, 016	20 A	1	25	0.5						26	1		EXIST. SPACE		T
	EXISTING REC	20 A	1	27			0.0				28	1		EXIST. SPACE		T
	EXISTING REC	20 A	1	29					0.0		30	1		EXIST. SPACE		$\top$
1	REC WORK ROOM 016	20 A	1	31	1.1						32	1		EXIST. SPACE		T
1	REC WORK ROOM 016	20 A	1	33			1.1				34	1		EXIST. SPACE		T
1	REC WORK ROOM 016	20 A	1	35					1.1		36	1		EXIST. SPACE		T
1	BAS	20 A	1	37	0.0						38	1		EXIST. SPACE		T
	EXISTING REC	20 A	1	39			0.0				40	1		EXIST. SPACE		T
	EXISTING REC	20 A	1	41					0.0		42	1		EXIST. SPACE		$\top$
		тот	AL L	OAD:	2 k	VΑ	3 k	VΑ	2 k	VA						
				MPS:		) A	L.,	7 A		5 A						
LOAI REC	O CLASSIFICATION	CONN 774	O VA			<b>DEMAN</b> 100.009			TIMATE 740 VA					PANEL TOTALS	5	_
SPEC			VA	`		0.00%		<b>'</b>	0 VA				CON	NECTED LOAD:	7740 VA	
														ATED DEMAND:		
				_									CONNEC	TED CURRENT:	21 A	
												E	ST. DEM	AND CURRENT:	21 A	
	ES (N):															

	LOCATION: OPEN OF MOUNTING: RECESS MAIN DEVICE: 150 A ML BUS AMPS: 150 AMP	FFICE 034 ED TYPE <sup>2</sup> .O			IING	FAN		VOLTA	GE: 20	A 000,	MPS S	/MN	METRICAL AD CENTE	R PANEL		
N	LOAD DESCRIPTION	RATING	Р	СКТ		A		3			СКТ	Р	RATING	LOAD DES	SCRIPTION	
	EXIST. REC S WALL	20 A	1	1	0.0	0.0					2	1	20 A	EXISTING REC	EAST RECEPT	
	EXIST. BASEMENT CRT	20 A	1	3			0.0	0.0			4	1	20 A	EXISTING REC	EAST RECEPT	
	EXIST. REC NE CORNER	20 A	1	5					0.0	0.0	6	•	45.0	EVICTING CDAI	D.F.	
	EXIST. REC BELOW PANEL	20 A	1	7	0.0	0.0					8	2	15 A	EXISTING SPAF	KE	
	EXIST. INSTANT CASH	20 A	1	9			0.0	0.2			10	1	20 A	REC PRINTING	017	
	EXIST. OFFICE HEAT	20 A	1	11					0.0	0.0	12	1	20 A	EXISTING MOD	EM	
	EXIST. OFFICE REC/LTG	20 A	1	13	0.0	0.0					14	1	20 A	EXISTING RECE	EP E. WALL	
	EXIST. OFFICE COPY MACH	20 A	1	15			0.0	0.0			16	_	00.4	EXISTING PRIV	ATE CLIENT	
1	REC PRINTING 017	20 A	1	17					0.9	0.0	18	2	20 A	SERVICES AIR	HANDLER	
				19	3.7	0.2					20	1	20 A	REC OPEN OFF	FICE 021	
1	1ST LEVEL SYS FURN	20 A	3	21			0.0	0.5			22	1	20 A	REC OP OFF 10	02 PRINTERS	
				23					0.0	0.2	24	1	20 A	REC PRINTING	017	
		TOTA	L L	OAD:	4 k	VΑ	1 k	VA	1 k	VA						
		TOTA				3 A	_	Α	_	Α						
	DAD CLASSIFICATION ther EC	CONN				DEMAN			TIMATE 3744 VA					PANEL TOTALS	<b>S</b> ⊺	
REC		198				100.00			980 VA				CON	NECTED LOAD:	Δ <b>D</b> : 5724 \/Δ	
INLO		1980 VA				100.00	70	'	300 VA					ATED DEMAND:		
														TED CURRENT:		
												E	EST. DEM	AND CURRENT:	16 A	

		ON 1450	211.040		VOLTAGE: 2009//400 V 2 = 4 W							
_		ON: MEC		ONII V		<b>VOLTAGE</b> : 208Y/120 V. 3 Ø 4 W.						
ı			A MAIN LUG	ONLY	A.I.C	- ,	AMPS SYMMETRICAL					
	BUS AM	I <b>PS</b> : 600	AMPS			SPECIAL:						
0167	<b>50.145</b>	201 50	D.4.7.N.O			DECODIDE	1/41414ED1 ATE					
CKT 1	60 A	POLES 3	60 A	Load 0.0 kVA	EVICTING DDIVA		VNAMEPLATE CES HEAT BANK.					
2	30 A	3	30 A	0.0 kVA		LOBBY HEATER	CES REAT BAINK.					
3	30 A	3	30 A	0.0 kVA	EXISTING WEST							
4	30 A	3	30 A	0.0 kVA	EXHAUST FAN	LODDITILATEN		-				
<del>_</del>	30 A	3	30 A	0.0 kVA	EXISTING AHU 1							
6	60 A	3	60 A	0.0 kVA	EXISTING AHU 2							
7	60 A	3	60 A	0.0 kVA	EXISTING LOAD							
8	100 A	3	100 A	30.5 kVA	MTS-IT/PANEL IT	Γ						
9	100 A	3	100 A	0.0 kVA	EXISTING BASE	MENT DUCT HEAT	ER					
10	100 A	3	100 A	0.0 kVA	EXISTING PRIVA	TE CLIENT SERVI	CES AIR CONDITIONER					
11	200 A	3	200 A	0.0 kVA	SPARE							
12	100 A	3	100 A	0.0 kVA	SPARE BREAKE	***						
13	100 A	3	100 A	0.0 kVA	SPARE BREAKE	***						
14	100 A	3	400 A	0.0 kVA	SPARE PREPAR	ED SPACE						
					1							
LOAD (	CLASSIFIC	ATION		CONNECTED	DEMAND	ESTIMATED	PANEL TOTA	LS				
Other	·			0 VA	0.00%	0 VA						
REC				12263 VA	90.77%	11131 VA						
SPEC				17040 VA	100.00%	17040 VA						
MTR				2288 VA	125.00%	2860 VA						
							CONN. LOAD:	30475 V				
							EST. DEMAND LOAD:	29970 V				
							CONN. CURRENT:	85 A				
							EST. DEMAND CURRENT:	83 A				

	LOCATION: STOR 02: MOUNTING: RECESSI MAIN DEVICE: 225 A ML BUS AMPS: 225 AMPS	ED TYPE <sup>·</sup> O	1	-		PAN					-		I. METRICAL		
N	LOAD DESCRIPTION	RATING	Р	СКТ	,	A		В	(	3	СКТ	Р	RATING	LOAD DESCRIPTION	
	00011.0.00.0	0F A	_	1	1.1	0.2					2	1	20 A	REC - EWC	
	SSCU-2, SS-2	25 A	2	3			1.1	0.4			4	1	20 A	REC WORK ROOM 017	
	REC OFFICE 032	20 A	1	5					1.1	0.4	6	1	20 A	REC MEETING 022A FLR BXES	S
	REC MEETING 022A	20 A	1	7	0.4	1.2					8	1	20 A	REC WORK 121 COPIER	
	REC MEETING 022A	20 A	1	9			0.4	0.2			10	1	20 A	1ST LEVEL COPIER FLR BOX	
	SYS FURN OPEN OFFICE	20. 4	2	11					0.8	0.2	12	1	20 A	1ST LEVEL COPIER FLR BOX	
	120	20 A	2	13	0.0	0.5					14	1	20 A	1ST LEVEL SYS FURN	
	REC ROOM 101A	20 A	1	15			0.7	0.5			16	1	20 A	REC - 121-122	
	REC ROOM 102, 102A	20 A	1	17					1.1	0.0	18	1	20 A	SYS FURN OPEN OFFICE 120	
	1ST LEVEL SYS FURN	20 A	1	19	0.5	0.0					20	1	20 A	SYS FURN OPEN OFFICE 120	
	1ST LEVEL COPIER FLR BOX	20 A	1	21			0.2	1.1			22	1	20 A	REC - 101, 120	
	REC,HARDWIRED-RR 002,3	20 A	1	23					0.5	0.4	24	1	20 A	REC MEETING 022	
	SYS FURN, 120, 123 REC	20 A	1	25	0.5	0.9					26	1	20 A	REC HALL 026	
	RESTRM REC, WIRED VLVS	20 A	1	27			1.1	1.1			28	1	20 A	EF-2; REC MEETING 022A	
	REC MEETING 022A	20 A	1	29					0.7	0.4	30	1	20 A	REC MEETING 022A	
	REC MEETING 022A	20 A	1	31	0.4	0.4					32	1	20 A	REC MEETING 022A	
	REC MEETING 022A	20 A	1	33			0.4	0.4			34	1	20 A	REC MEETING 022A	
	SPARE	20 A	1	35					0.0		36	1		SPACE	
	SPARE	20 A	1	37	0.0						38	1		SPACE	
	SPARE	20 A	1	39			0.0				40	1		SPACE	
	SPARE	20 A	1	41					0.0		42	1		SPACE	
	SPARE	20 A	1	43	0.0						44	1		SPACE	
	SPARE	20 A	1	45			0.0				46	1		SPACE	
	SPARE	20 A	1	47					0.0		48	1		SPACE	
	SPARE	20 A	1	49	0.0						50	1		SPACE	
	SPARE	20 A	1	51			0.0				52	1		SPACE	
	SPARE	20 A	1	53					0.0		54	1		SPACE	
	SPARE	20 A	1	55	0.0						56	1		SPACE	
	SPARE	20 A	1	57			0.0				58	1		SPACE	
	SPARE	20 A	1	59					0.0		60	1		SPACE	
	1	ТОТ	AL L	OAD:	6 k	:VA	7 k	VA	5 k	VA			1	I.	
				MPS:		Α	L .	3 A		5 A					_
<b>LOAI</b> Other	D CLASSIFICATION	CONN	ECT VA	ED		<b>DEMAN</b> 0.00%		ES	TIMATE 0 VA	:D				PANEL TOTALS	
REC		1559		'A		82.07%		1:	2796 VA				CON	NECTED LOAD: 18873 VA	_
SPEC			) VA		+	100.009			840 VA					ATED DEMAND: 16645 VA	_
MTR		249	2 V	4		122.95	%	3	3064 VA				CONNEC	TED CURRENT: 52 A	
												E	EST. DEM	AND CURRENT: 46 A	

	LOCATION: DATA 012  MOUNTING: SURFACE  MAIN DEVICE: 100 A ML	E TYPE 1		N	EW	PAN	,	VOLTA		8Y/120 ,000 A <b>l</b>	/IPS S	YMN	IETRICAL /E DEVICI	<b>.</b>		1	
	BUS AMPS: 100 AMP	S				_										Τ	
N	LOAD DESCRIPTION	RATING	Р	CKT 1	1.1	<b>A</b>		B 	(	;	<b>CKT</b> 2	<b>P</b>	20 A	FACP	SCRIPTION	+	
	SSCU-1, SS-1	25 A	2	3	1.1	0.6	11	0.2			4	1	20 A 20 A	REC DATA 015	IT DACK		
							1.1	0.2	4.9	0.4	-		-			$\vdash$	
	UPS	60 A	2	5	4.0	0.4			4.9	0.4	6	1	20 A	REC DATA 015		+	
	DEC 0700 400	00.4	_	7	4.9	0.4	0.4	4.0			8	1	20 A	REC DATA 015			
	REC STOR 130	20 A	1	9			0.4	1.0	0.4	4.4	10	1	20 A	DOOR POWER		+	
	REC STOR 022B AV RACK	20 A	1	11	4.0	4.4			0.4	1.4	12	1	20 A	DOOR POWER			
	DR PWR SUPPLY; CNTRLLR	20 A	1	13	1.0	1.4	0.0				14	1		DR PWR SUPPI			
	DR PWR SUPPLY; CNTRLLR	20 A	1	15			0.0	1.4		4.0	16	1	20 A	DOOR POWER		$\perp$	
	DR PWR SUPPLY; CNTRLLR	20 A	1	17					0.0	1.0	18	1	20 A	DOOR POWER			
	DOOR POWER SUPPLIES	20 A	1	19	1.5	1.0					20	1	20 A	DOOR CONTRO		-	
	SPEC OPEN OFFICE 120	20 A	1	21			1.0	1.4			22	1	20 A	DR PWR SUPPI	•		
	DOOR POWER SUPPLIES	20 A	1	23					1.4	1.4	24	1	20 A	DOOR POWER	SUPPLIES		
	DOOR POWER SUPPLIES	20 A	1	25	1.4						26	1		SPACE		_	
	REC STOR 022B AV RACK	20 A	1	27			0.4				28	1		SPACE			
	REC IT CNTRL 152 AV RACK	20 A	1	29					0.4		30	1		SPACE			
	REC IT CNTRL 152 AV RACK	20 A	1	31	0.4						32	1		SPACE			
	SPARE	20 A	1	33			0.0				34	1		SPACE			
	SPARE	20 A	1	35					0.0		36	1		SPACE			
	SPARE	20 A	1	37	0.0						38	1		SPACE			
	SPARE	20 A	1	39			0.0				40	1		SPACE			
	SPARE	20 A	1	41					0.0		42	1		SPACE			
				OAD:		kVA		XVA	111		-						
ΟΛ	D CLASSIFICATION	CONN		MPS:		3 A <b>DEMAN</b>		7 A	94 Timate					PANEL TOTALS	<u> </u>		
REC		1226				90.77%			1131 VA					TANLE TOTAL			
PE		17040 VA			100.00			7040 VA				CON	NECTED LOAD:	30475 VA			
/ITR		2288 VA			125.00	%	2	860 VA				ESTIMA	ATED DEMAND:	29970 VA			
														TED CURRENT:	-		
												E	ST. DEM	AND CURRENT:	83 A		

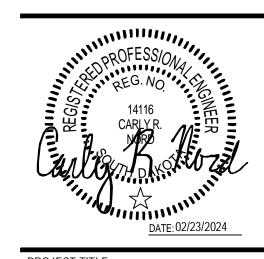

14 W. Kemp Ave. Watertown, SD 57201

> (605) 884-7090 www.teamtsp.com

> > Architecture

Engineering

CONSULTANTS

CITY OF WATERTOWN RENOVATION AND ADDITION FOR NEW CITY HALL WATERTOWN, SD

ADD1	03/05/2024	ADDENDUM 1				
ISSUE	DATE	DESCRIPTION				
ICCUE DATE		DD AMAN DV				
ISSUE DATE		DRAWN BY				
02/23/2024	1	CRN				
	•	•				
PROJECT #	<u>.                                      </u>	CHECKED BY				

ELECTRICAL PANEL

SCHEDULES